IREDELL COUNTY HEALTH DEPARTMENT

THIS PERMIT VOIDS PREVIOUS ISSUED 7-7-04 #121794

STATESVILLE 704-878-5305 (C1) MOORESVILLE 704-664-5281

IMPROVEMENT PERMIT / AUTHORIZATION TO CONSTRUCT / OPERATION PERMIT / EXISTING SYSTEM INSPECTION

PERMIT# 12477 PIN# 4777-66-9778 DATE 10-29-04

OWNER OR CONTRACTOR PAUL McCAMPBELL PHONE: Business 704-664-5800 Home

ADDRESS 359 WHITE OAK BRANCH STATESVILLE NC 28625

LOCATION OLD MOCKSVILLE ROAD TO WHITE OAK BRANCH RD, 0.6 MILE ON RIGHT AT BOX # 359 BACK OFF ROAD

SUBDIVISION BLOCK / SECTION LOT LOT AREA 4.97± ACRES SITE CLASS. PS DESIGN FLOW 360 L.T.A.R. 0.30 GPD/FT²

Septic Tank: EXISTING Gallons: STB Date

Pump Tank: Gallons; PT Date

Pump Make: Model EQ. TO Serial No.

Nitrification Field: No Fields 1 Square Feet 440 Linear Feet 110

No Lines TWO Trench Width 36" Max Trench Bottom Depth 36" Gravel Depth NA

☑ New System ☐ Repair System Type: I, II, (III) IV, V, VI

System Description: 25% REDUCTION, GRAVITY

Repair System Description: 50% REDUCTION LOW PRESSURE

Maintenance Agreement Required: ☐ Yes ☑ No

☑ House/Mod. Home No. Bedrooms 3

☐ Mobile Home No. Bathrooms

☐ Business No. Employees

☐ Other


☐ Slab ☐ Crawl Space ☑ Basement w/plumbing ☐ Basement wo/plumbing

Water Supply: ☑ Individual ☐ Public ☐ Community WELL


Comments:/Conditions: INSTALL 25% REDUCTION SYSTEM AS FLAGGED USING ONE DISTRIBUTION BOX AND ONE DROP BOX AS SHOWN FOR SERIAL DISTRIBUTION

Comments:/Conditions:

INITIAL SITE SKETCH

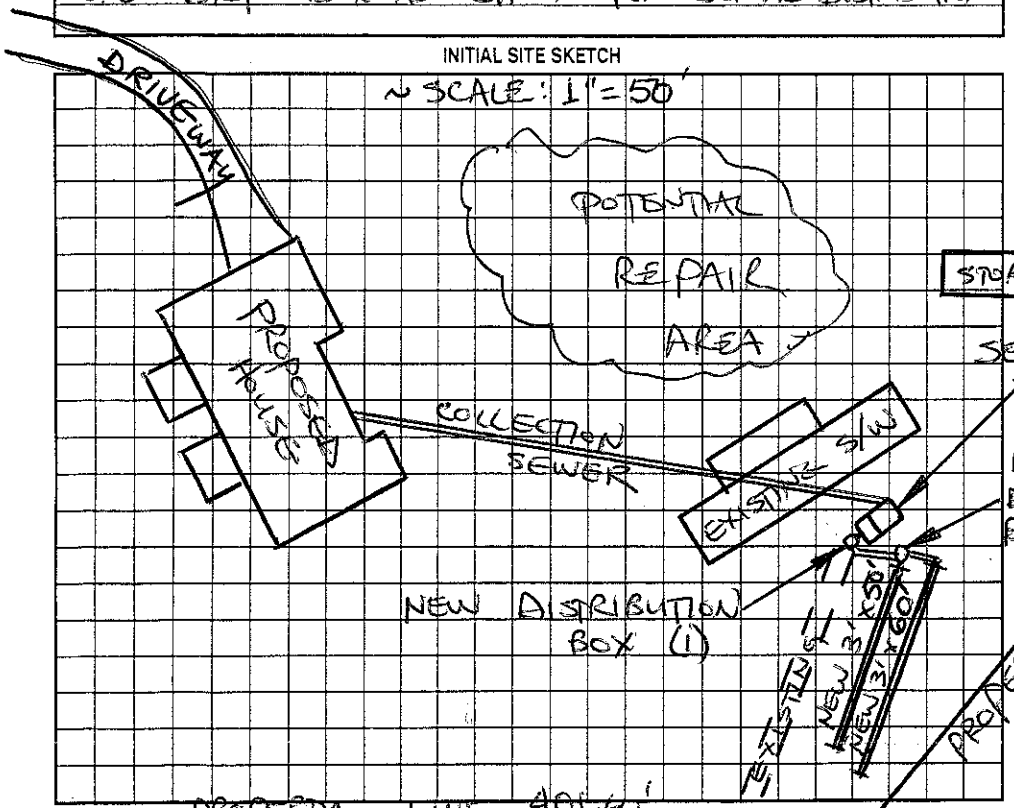

AS BUILT SKETCH

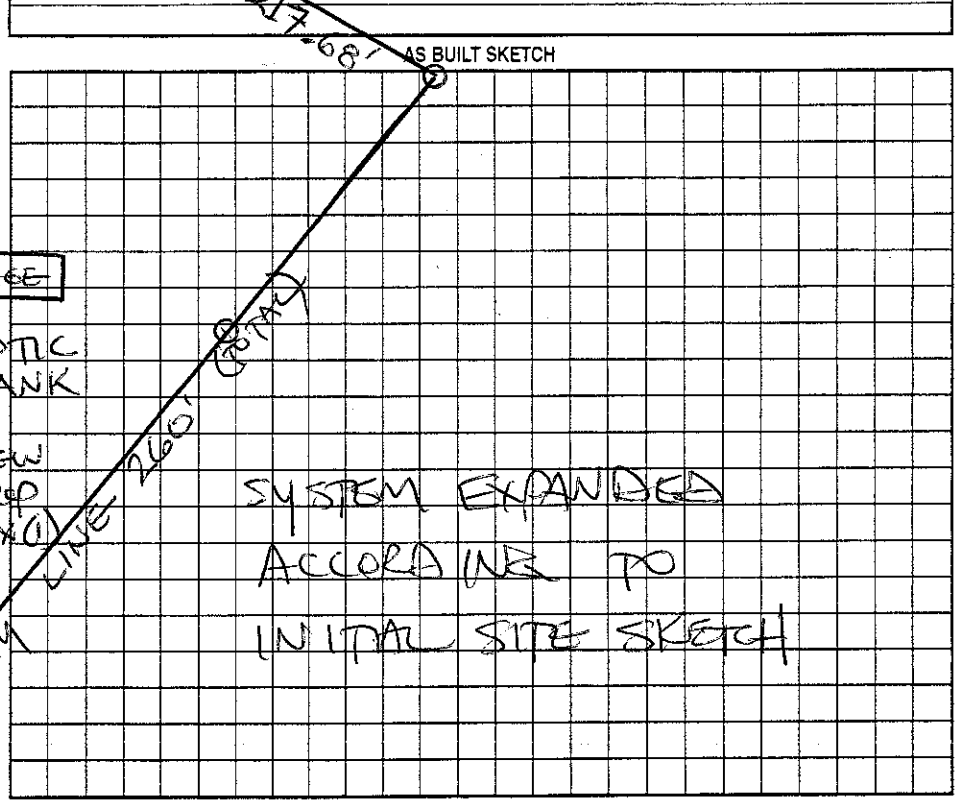

Permit can be suspended or revoked if any false information is supplied toward securing the permit/any unauthorized changes are made to the site/any unauthorized changes are made in the installation of the system. Improvement Permit with plat valid without expiration. Improvement Permit with site plan valid for sixty months. Authorization to Construct is valid for a period equal to that of Improvement Permit – not to exceed sixty months.

Signed: Steve Hedrick date 2/23/05

Improvement Permit by: STEVE HEDRICK date 10-29-04

Authorization to Construct by: STEVE HEDRICK date 10-29-04

Installed by: IREDELL BACKHOE

Operation Permit by: STEVE HEDRICK date 3-7-05

Existing System Inspection by: date

HEALTH DEPT. COPY: WHITE OWNER COPY (FINAL): YELLOW OWNER COPY (INITIAL): PINK