IREDELL COUNTY HEALTH DEPARTMENT

STATESVILLE 704-878-5305 MOORESVILLE 704-664-5281

IMPROVEMENT PERMIT / AUTHORIZATION TO CONSTRUCT / OPERATION PERMIT / EXISTING SYSTEM INSPECTION

PERMIT# 121794 PIN# 4777-66-9778 DATE 7-7-04

OWNER OR CONTRACTOR America's Home Place / Paul McCampbell PHONE: Business (704) 664-5800 Home (704) 953-6844

ADDRESS 168 Norman Station Blvd Suite D Mooresville NC 28117

LOCATION 21N (L) Jane Sowers Rd (L) Old Mocksville Rd (R) White Oak Branch Rd (R) at 359 White Oak Branch Rd.

SUBDIVISION _____ BLOCK / SECTION _____ LOT _____ LOT AREA _____ SITE CLASS. PS DESIGN FLOW 240 L.T.A.R. Existing

Septic Tank: Exist Gallons; STB _____ Date _____
Pump Tank: _____ Gallons; PT _____ Date _____
Pump Make: _____ Model _____ Serial No. _____
Nitrification Field: No Fields 1 Square Feet _____ Linear Feet Exist
No Lines Ex. Trench Width _____ Max Trench Bottom Depth _____ Gravel Depth Ex.

☐ New System ☐ Repair System Type: I, II, III, IV, V, VI
System Description: Conventional / Gravity
Repair System Description: _____
Maintenance Agreement Required: ☐ Yes ☑ No

☑ House/Mod. Home No. Bedrooms 3
☐ Mobile Home No. Bathrooms 2
☐ Business No. Employees _____
☐ Other _____
☐ Slab ☐ Crawl Space ☑ Basement w/plumbing ☐ Basement wo/plumbing


Water Supply: ☑ Individual ☐ Public ☐ Community Well

Comments:/Conditions:


Comments:/Conditions: ① System functioning properly at time of inspection ② Permission to connect new structure to existing system ③ New structure shall not increase the number of bedrooms on system. ④ Existing MH shall be removed from site prior to start of construction ⑤ Existing Washing Machine shall be plumbed into existing system ⑥ This ~~letter~~ serves as a 30-DAY NOV to plumb washing machine into existing system on CA.

SCALE 1" = 100'

INITIAL SITE SKETCH

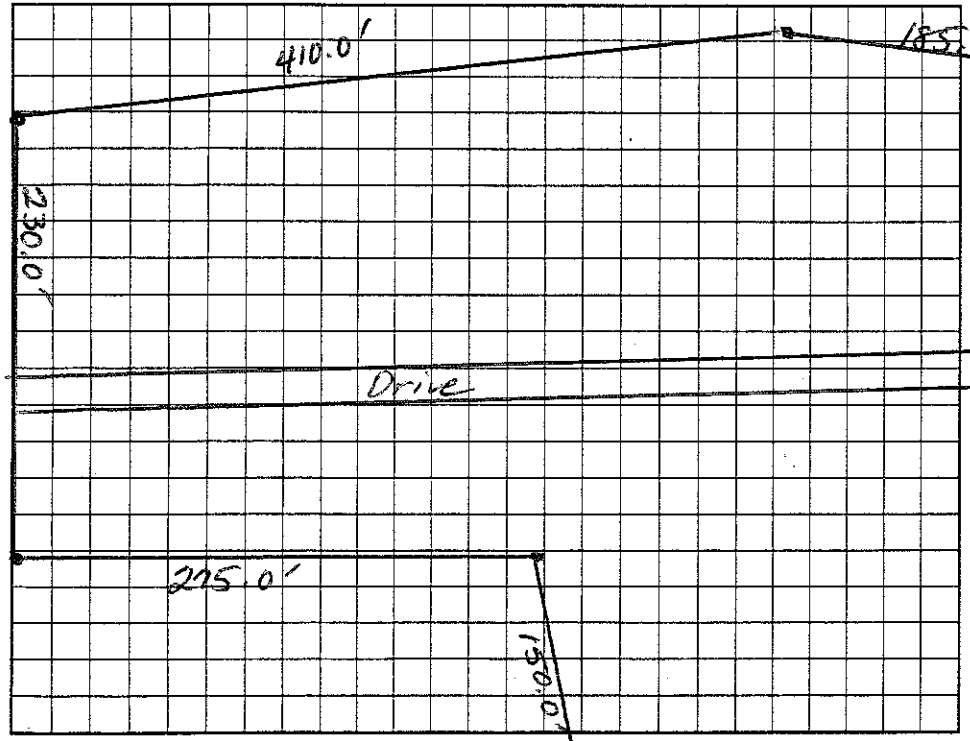

AS-BUILT SKETCH

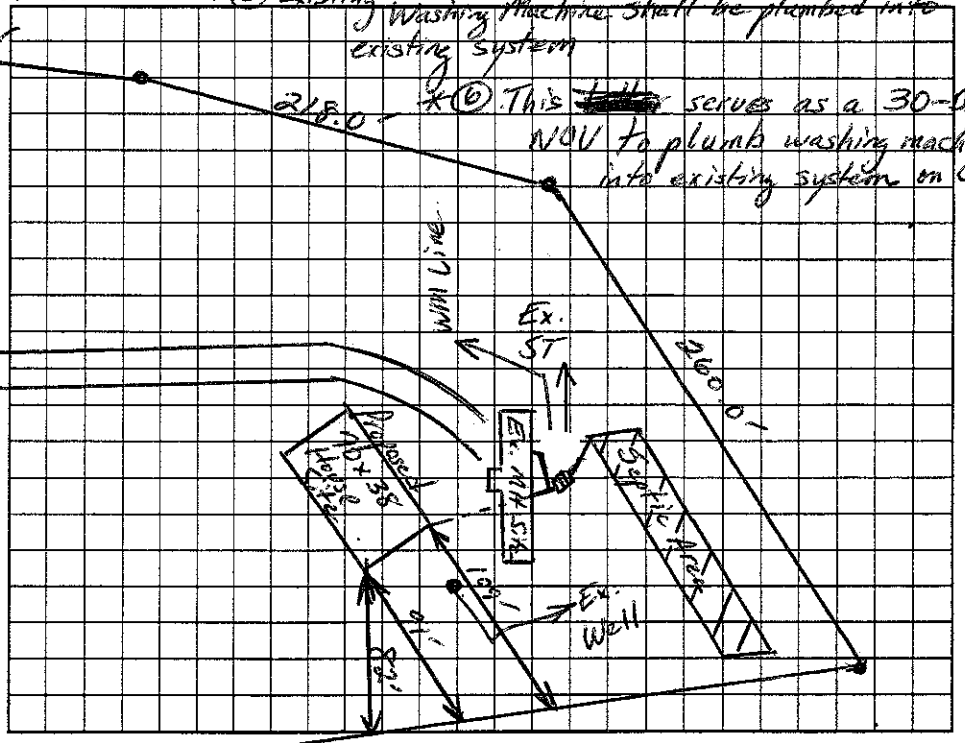

Permit can be suspended or revoked if any false information is supplied toward securing the permit/any unauthorized changes are made to the site/any unauthorized changes are made in the installation of the system. Improvement Permit with plat valid without expiration. Improvement Permit with site plan valid for sixty months. Authorization to Construct is valid for a period equal to that of Improvement Permit – not to exceed sixty months.

Signed: Joanna Bueck date 8/11/04

Improvement Permit by: _____ date _____

Authorization to Construct by: _____ date _____

Installed by: _____

Operation Permit by: _____ date _____

Existing System Inspection by: Christopher M. Shuman, PS date 7-7-04

HEALTH DEPT. COPY: WHITE OWNER COPY (FINAL): YELLOW OWNER COPY (INITIAL): PINK