IREDELL COUNTY HEALTH DEPARTMENT

IMPROVEMENT PERMIT / AUTHORIZATION TO CONSTRUCT / OPERATION PERMIT / EXISTING SYSTEM INSPECTION

STATESVILLE 704-878-5305 MOORESVILLE 704-664-5281

PERMIT# 48031 PIN# 4777685238

OWNER OR APPLICANT Alan & Pamela Lewis PHONE: Business 704-878-2305 Home

ADDRESS 115 New Hope Rd Statesville NC 28625 DATE 1-29-08

LOCATION Clarksville Rd (R) White Oak Branch (L) Deer Chase 2nd lot on Right

SUBDIVISION Deer Chase Park BLOCK / SECTION LOT 7 LOT AREA 1.369 SITE CLASS R5 DESIGN FLOW 360 L.T.A.R. .35

Septic Tank: 1050 Gallons; STB 1012 Date 8-20-08

Pump Tank: Gallons; PT Date

Pump Make: Model Serial No.

Nitrification Field: No Fields Square Feet 1440 Linear Feet 360

No Lines 5 Trench Width 36" Max Trench Bottom Depth 30'

☑ New System ☐ Repair ☐ Expansion System Type: I II (III) IV V VI

System Description: 2500 Gravity

Repair System Description: 2500 Gravity

Maintenance Agreement Required: ☐ Yes ☐ No

Gravel Depth NA ☑ Gravity ☐ Pressure ☑ Slab ☐ Crawl Space ☐ Basement w/plumbing ☐ Basement wo/plumbing

☐ House/Mod. Home No. Bedrooms 3

☐ Mobile Home No. Persons

☐ Business No. Employees

☐ Other


Water Supply: ☐ Individual ☑ Public ☐ Community

Comments:/Conditions:


Comments:/Conditions:

Install on Contour
Maintain all setbacks

INITIAL SITE SKETCH

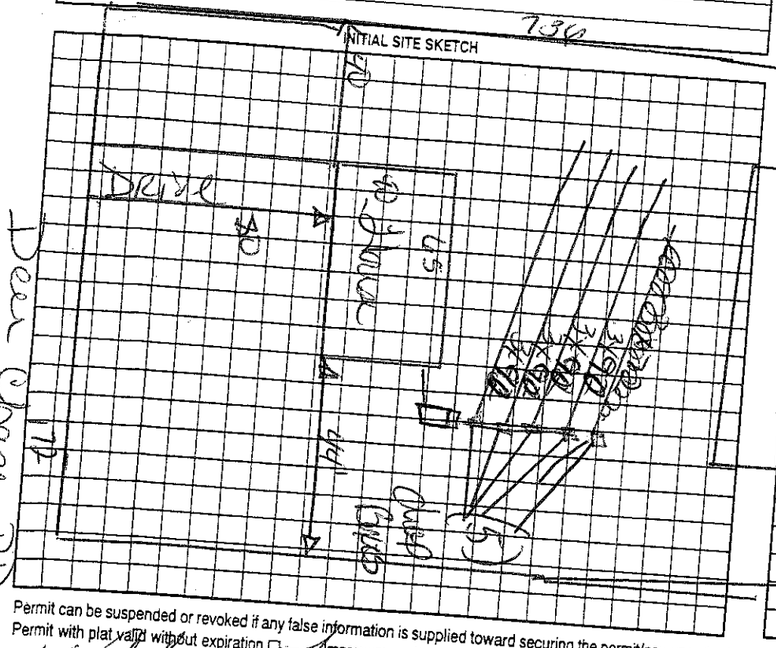

AS BUILT SKETCH

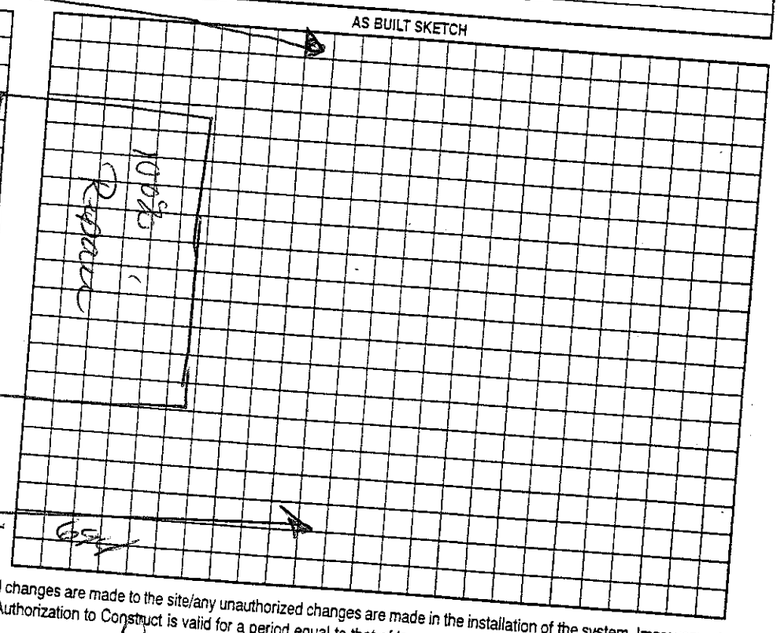

Permit can be suspended or revoked if any false information is supplied toward securing the permit/any unauthorized changes are made to the site/any unauthorized changes are made in the installation of the system. Improvement Permit with plat valid without expiration ☐ Improvement Permit with site plan valid for sixty months ☑ Authorization to Construct is valid for a period equal to that of Improvement Permit – not to exceed sixty months.

Signed: X

Improvement Permit by: date

Authorization to Construct by: date 1-29-08

Installed by: David Yount

Operation Permit by: date 1-30-08

Existing System Inspection by: date

HEALTH DEPT. COPY: WHITE OWNER COPY (FINAL): YELLOW OWNER COPY (INITIAL): PINK

Deer Chase