IREDELL COUNTY HEALTH DEPARTMENT

THIS PERMIT REPLACES PREVIOUS ISSUED 2-29-08 1:30

STATESVILLE 704-878-5305 MOORESVILLE 704-664-5281

IMPROVEMENT PERMIT / AUTHORIZATION TO CONSTRUCT / OPERATION PERMIT / EXISTING SYSTEM INSPECTION

PERMIT# 48306 PIN# 4777-68-3526 DATE 4-22-2008

OWNER OR APPLICANT JOSH LEWIS PHONE: Business 704-873-2884 Home 704-880-4217

ADDRESS 118 NEW HOPE ROAD, STATESVILLE NC 28625

LOCATION OLD MOCKSVILLE ROAD, TR, WHITE OAK BRANCH RD, TL DEERCHASE CIRCLE, 2ND ON RIGHT

SUBDIVISION DEERPARK BLOCK / SECTION ____ LOT 29 LOT AREA 0.63 ACRES SITE CLASS PS DESIGN FLOW 360 L.T.A.R. 0.25 GPD/FT²

Septic Tank: 1000 Gallons: STB 1012 Date 2-28-08

Pump Tank: ____ Gallons: PT ____ Date ____

Pump Make: ____ Model ____ Serial No. ____

Nitrification Field: No Fields 1 Square Feet 1440 Linear Feet 360

No Lines FIVE Trench Width 36" Max Trench Bottom Depth 36"

☑ New System ☐ Repair ☐ Expansion System Type: I II III IV V VI

System Description: 25% REDUCTION, GRAVITY

Repair System Description: 25% REDUCTION, PUMP

Maintenance Agreement Required: ☐ Yes ☑ No

Gravel Depth N/A ☑ Gravity ☐ Pressure ☐ Slab ☐ Crawl Space ☐ Basement w/plumbing ☐ Basement wo/plumbing

☑ House/Mod. Home No. Bedrooms 3

☐ Mobile Home No. Persons ____

☐ Business No. Employees ____


☐ Other ____

Water Supply: ☐ Individual ☑ Public ☐ Community


Comments/Conditions: INSTALL 25% REDUCTION SYSTEM ON CONTOUR USING SERIAL DISTRIBUTION

Comments/Conditions: Septic & Make Red Painted

INITIAL SITE SKETCH

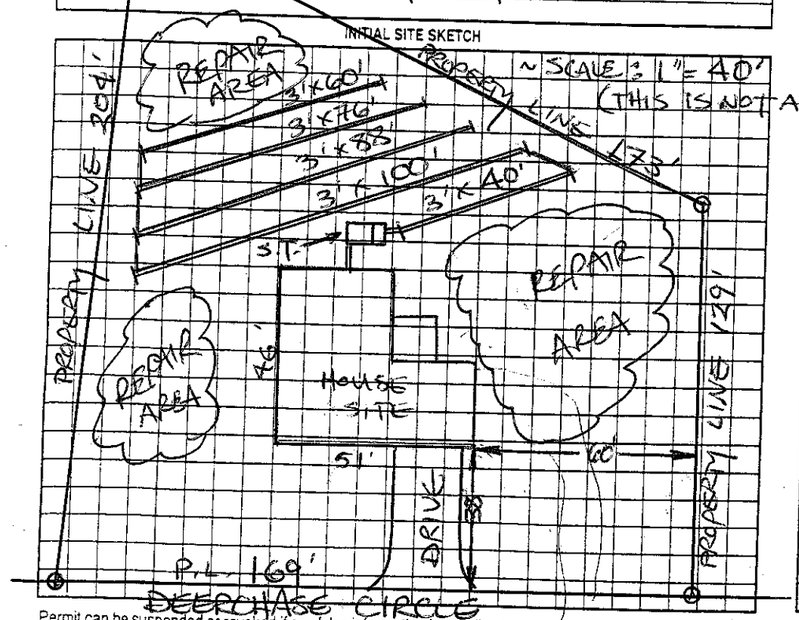

AS BUILT SKETCH

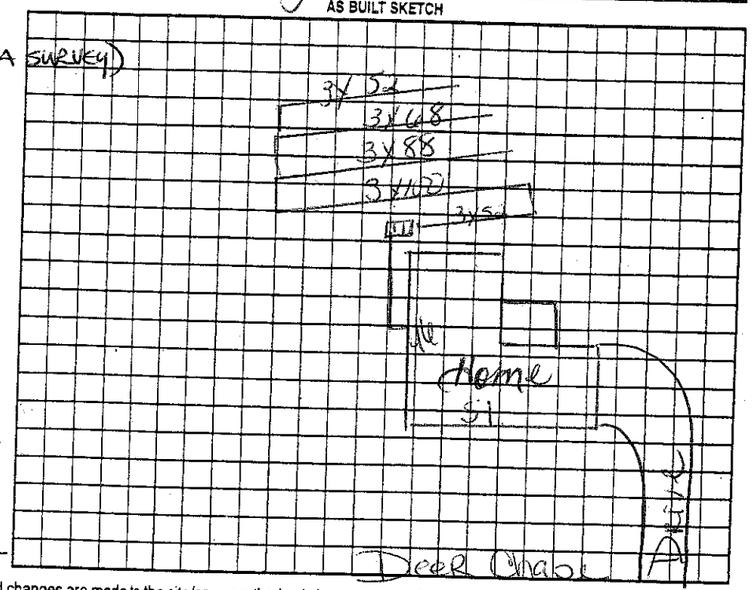

Permit can be suspended or revoked if any false information is supplied toward securing the permit/any unauthorized changes are made to the site/any unauthorized changes are made in the installation of the system. Improvement Permit with plat valid without expiration ☐ Improvement Permit with site plan valid for sixty months ☑ Authorization to Construct is valid for a period equal to that of Improvement Permit – not to exceed sixty months.

Signed: Joshua Lewis date 4/23/08

Improvement Permit by: STEVE HEDRICK date 4-22-08

Authorization to Construct by: STEVE HEDRICK date 4-22-08

Installed by: DAVID YOUNTZ

Operation Permit by: Keith Cook date 12-5-08

Existing System Inspection by: ____ date ____

HEALTH DEPT. COPY: WHITE OWNER COPY (FINAL): YELLOW OWNER COPY (INITIAL): PINK