CI/CI

IREDELL COUNTY HEALTH DEPARTMENT

STATESVILLE 704-878-5305 MOORESVILLE 704-664-5281

IMPROVEMENT PERMIT / AUTHORIZATION TO CONSTRUCT / OPERATION PERMIT / EXISTING SYSTEM INSPECTION

PERMIT# 102839 PIN# 4777-68-4908 DATE 10-18-01

OWNER OR CONTRACTOR ALAN LEWIS PHONE: Business Home 704-878-2305

ADDRESS 118 NEW HOPE ROAD STATESVILLE NC 28625

LOCATION HWY 64 E, ⓒ OLD MOORESVILLE, ⓓ WHITE OAK BRANCH, ⓔ DEERCHASE, 300' ON LEFT

SUBDIVISION DEER PARK BLOCK / SECTION LOT 10 LOT AREA 3.11 AC SITE CLASS PS DESIGN FLOW 480 L.T.A.R. .3

Septic Tank: 1500 Gallons; STB 1011 Date 9-21-01
Pump Tank: Gallons; PT Date
Pump Make: Model Serial No.
Nitrification Field: No Fields 1 Square Feet 1600' Linear Feet 533'
No Lines 4X133' Trench Width 36" Max Trench Bottom Depth 36" Gravel Depth 12"

X New System ☐ Repair System Type: ⓘ II. III. IV. V. VI
System Description: GRAV CONV
Repair System Description: SAME
Maintenance Agreement Required: ☐ Yes X No
X Slab ☐ Crawl Space ☐ Basement w/plumbing ☐ Basement wo/plumbing


☐ House/Mod. Home No. Bedrooms 4
☐ Mobile Home No. Bathrooms 2
☐ Business No. Employees
X Other DUPLEX APT

Water Supply: ☐ Individual X Public ☐ Community

Comments/Conditions: ① USE 1500 GAL TANK ② INSTALL LINES ON CONTOURS ③ MAINTAIN SETBACKS

Comments/Conditions: RISER EXPOSED, POLYLOK FILTER, INSTALLED AS SHOWN.

INITIAL SITE SKETCH

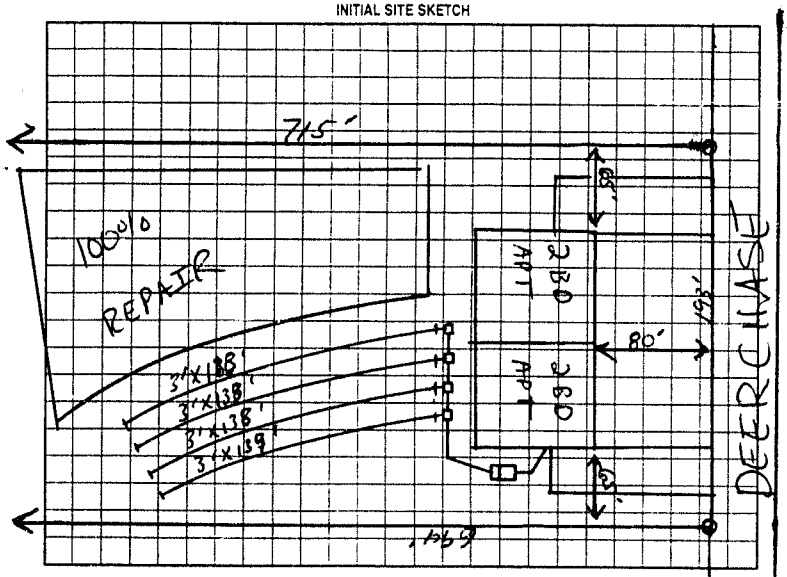

AS BUILT SKETCH

Permit can be suspended or revoked if any false information is supplied toward securing the permit/any unauthorized changes are made to the site/any unauthorized changes are made in the installation of the system. Improvement Permit with plat valid without expiration. Improvement Permit with site plan valid for sixty months. Authorization to Construct is valid for a period equal to that of Improvement Permit – not to exceed sixty months.

Signed: Alan Lewis date

Improvement Permit by: RS date 10-18-01

Authorization to Construct by: RS date 10-18-01

Installed by: DAVID YOUNTZ

Operation Permit by: RS date 05-07-02

Existing System Inspection by: date

HEALTH DEPT. COPY WHITE OWNER COPY (FINAL) YELLOW OWNER COPY (INITIAL) PINK