4:00

IREDELL COUNTY HEALTH DEPARTMENT

STATESVILLE 704-878-5305 MOORESVILLE 704-664-5281

IMPROVEMENT PERMIT / CERTIFICATE OF COMPLETION / OPERATION PERMIT / EXISTING SYSTEM INSPECTION

PROPERTY DESCRIPTION NO. 21456 DATE 7-5-95 TAX MAP NO. 111-2-A-2 Watershed: ☐ Yes ☑ No

OWNER OR CONTRACTOR Silverwave Properties PHONE: Business 704 532 6524 Home

ADDRESS 5551 Monroe Rd Charlotte, N.C. 28212

LOCATION 64 E To Cool Springs Rd To Riverhill 5th lot on left

SUBDIVISION Coolwood BLOCK / SECTION LOT 2 LOT AREA .67 acres SITE CLASS. PS DESIGN FLOW 360 L.T.A.R. .3

Septic Tank: 1000 Gallons; STB 238 Date 11-2-95
Pump Tank: Gallons; PT Date
Pump Make: Model Serial No.
Nitrification Field: No Fields 1 Square Feet 1200 Linear Feet 400
No Lines 4 Trench Width 36" Max Trench Bottom Depth 36" Gravel Depth

☐ New System ☐ Repair System Type: I, II, III, IV, V, VI
System Description: conv. Gravity
Repair System Description Pump to Conv. Lines
Maintenance Agreement Required: ☐ Yes ☑ No


☐ House/Mod. Home No. Bedrooms 5
☑ Mobile Home No. Bathrooms 2
☐ Business No. Employees
☐ Other
☐ Slab ☑ Crawl Space ☐ Basement w/plumbing ☐ Basement wo/plumbing

Water Supply: ☐ Individual ☐ Community ☑ Public


Comments:

Comments: Home moved back to 96' from Riverhill Road. Application show 70' therefore had to add 5th line to get 400' remaining of repair area will have to be moved to front

INITIAL SITE SKETCH

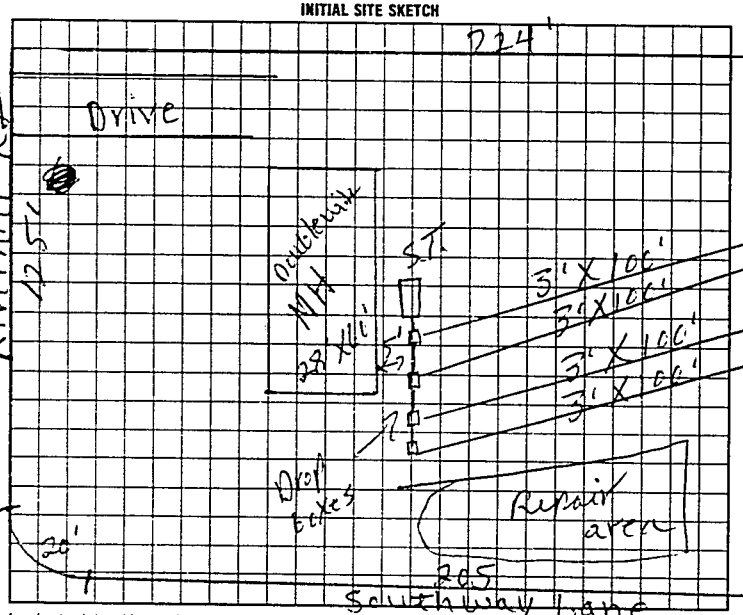

AS BUILT SKETCH

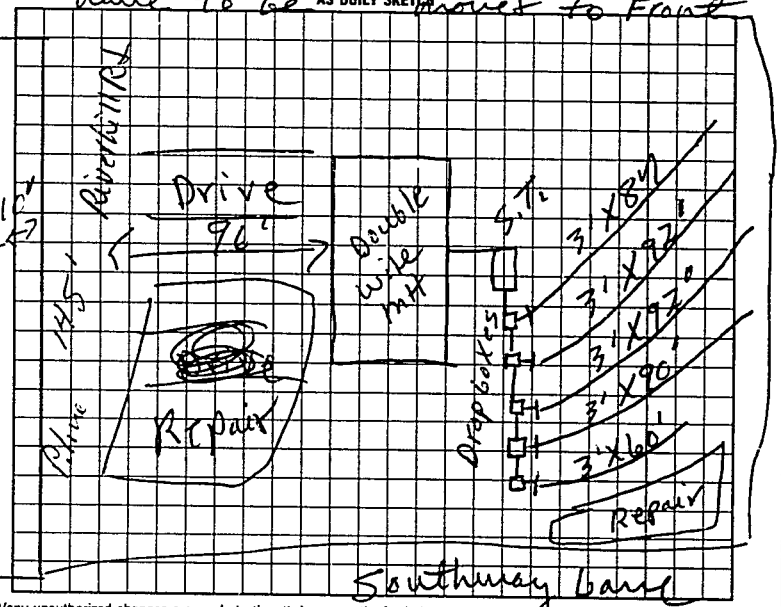

I understand that this permit can be suspended or revoked if any false information is supplied toward securing the permit/any unauthorized changes are made to the site/any unauthorized changes are made in the installation of the system. Improvement Permit is valid for 60 months from date of issuance.

Signed:

Improvement Permit by: J.C. Moore date 7-5-95

Existing System Inspection by: date

Installed by: H.B. Salmons

Certificate of Completion by: J.C. Moore date 2-19-96

Operation Permit by: J.C. Moore date 2-19-96

HEALTH DEPT. COPY: WHITE INSPECTION COPY (FINAL) GREEN OWNER COPY (FINAL) YELLOW INSPECTION COPY (INITIAL) PINK OWNER COPY (INITIAL) GOLD