IREDELL COUNTY HEALTH DEPARTMENT

STATESVILLE 704-878-5305 MOORESVILLE 704-664-5281

IMPROVEMENT PERMIT / AUTHORIZATION TO CONSTRUCT / OPERATION PERMIT / EXISTING SYSTEM INSPECTION

PERMIT# 79010 PIN# 4777 71 3509 DATE 1-25-99

OWNER OR CONTRACTOR Mergel Klaus PHONE: Business _____ Home 924 7676

ADDRESS 128 Southway Lane

LOCATION Rivercrest Rd TR/Southway Ln 2nd lot Rt

SUBDIVISION Coolwood BLOCK / SECTION _____ LOT 47 LOT AREA .75acres SITE CLASS PS DESIGN FLOW 360 L.T.A.R. .3

Septic Tank: 1000 Gallons; STB 160 Date 3-4-99

Pump Tank: _____ Gallons; PT _____ Date _____

Pump Make: _____ Model _____ Serial No _____

Nitrification Field: No Fields 1 Square Feet 1200 Linear Feet 400

No Lines 4 Trench Width 36" Max Trench Bottom Depth 24" Gravel Depth 12"

~~New System~~ Repair System Type: I, II, IV, V, VI

System Description: Conv. Gravity

Repair System Description: Gravity 2530Rd

Maintenance Agreement Required: Yes ~~No~~

House/Mod Home No. Bedrooms 3

~~Mobile Home~~ No. Bathrooms 2

Business No. Employees _____

Other _____


~~Slab~~ Crawl Space Basement w/plumbing Basement wo/plumbing

Water Supply: Individual ~~Public~~ Community

Comments/Conditions:


200'

INITIAL SITE SKETCH

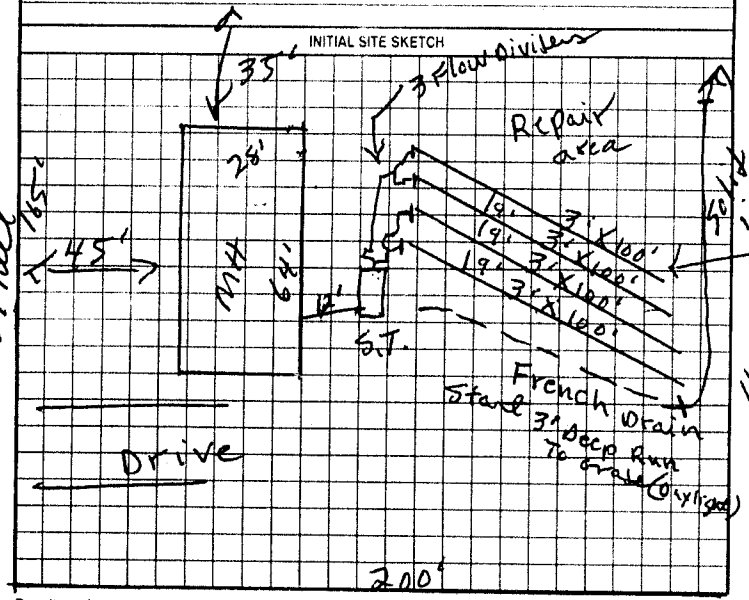

Comments/Conditions

AS BUILT SKETCH

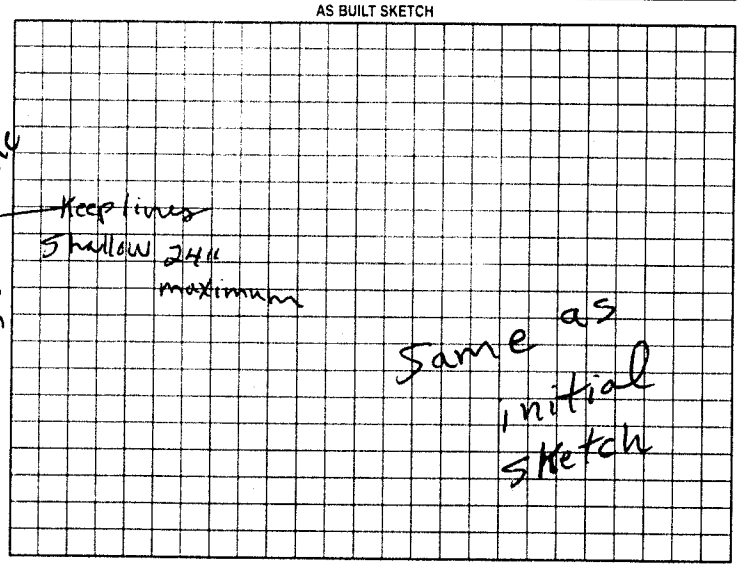

Permit can be suspended or revoked if any false information is supplied toward securing the permit/any unauthorized changes are made to the site/any unauthorized changes are made in the installation of the system. Improvement Permit with plat valid without expiration. Improvement Permit with site plan valid for sixty months. Authorization to Construct is valid for a period equal to that of Improvement Permit – not to exceed sixty months.

Signed: X Klaus Mergel date 1/25/99 Installed by: Hickory Backhoe

Improvement Permit by: P.C. Moore date 1-25-99 Operation Permit by: P.C. Moore date 4-9-99

Authorization to Construct by: P.C. Moore date 1-25-99 Existing System Inspection by: _____ date _____

HEALTH DEPT COPY: WHITE OWNER COPY (FINAL): YELLOW OWNER COPY (INITIAL): PINK