IREDELL COUNTY HEALTH DEPARTMENT

STATESVILLE 704-878-5305 MOORESVILLE 704-664-5281

IMPROVEMENT PERMIT / CERTIFICATE OF COMPLETION / OPERATION PERMIT / EXISTING SYSTEM INSPECTION

PROPERTY DESCRIPTION NO. 23004 DATE 2/13/96 TAX MAP NO 11C-2-A-49 Watershed: ☐ Yes ☑ No

OWNER OR CONTRACTOR Anthony TAGNER PHONE: Business Home 871-5605

ADDRESS PO BOX 5094 Statesville NC 28687

LOCATION 64 E to 80 Riverhill, Rt of Stop Sign, Rt on Southway, At Corner on North Field

SUBDIVISION Cool Springs (Connected) LOT 49 LOT AREA 125X215 SITE CLASS P3 DESIGN FLOW 360gpd L.T.A.R. 0.3 gpd/ft²

Septic Tank: 1000 Gallons: STB 521 Date 1-3-96

Pump Tank: Gallons: PT Date

Pump Make: Model Serial No

Nitrification Field: No Fields 1 Square Feet 1200 Linear Feet 400

No Lines 4 Trench Width 3' Max Trench Bottom Depth 36" Gravel Depth 12"

☑ New System ☐ Repair System Type: ☐ II ☐ III ☐ IV ☐ V ☐ VI

System Description: conv gravity

Repair System Description conv gravity

Maintenance Agreement Required: Yes No

☐ Slab ☐ Crawl Space ☐ Basement w/plumbing ☐ Basement wo/plumbing

☐ House/Mod. Home No Bedrooms 3

☐ Mobile Home No Bathrooms 2

☐ Business No Employees


☐ Other

Water Supply: ☐ Individual ☐ Community ☑ Public

Comments: Keep System 10' from Lot Line

Comments

INITIAL SITE SKETCH

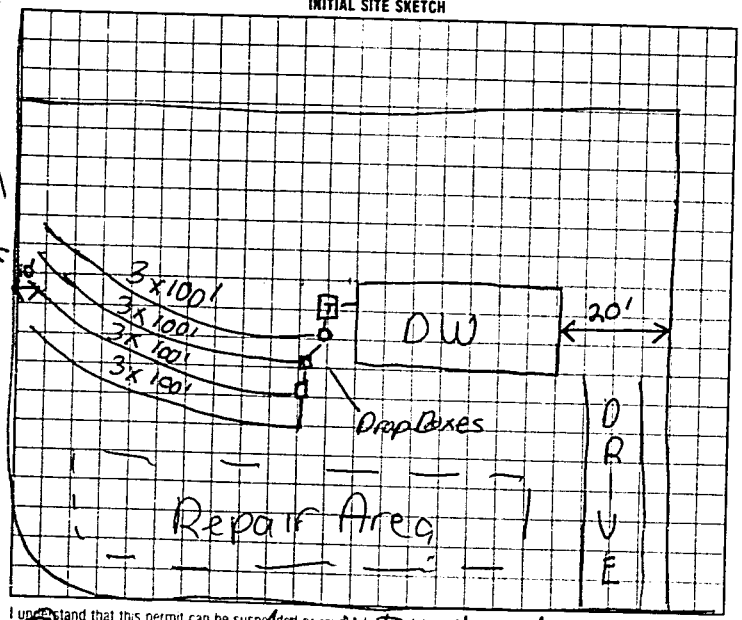

AS BUILT SKETCH

Same as initial Sketch

I understand that this permit can be suspended or revoked if any false information is supplied toward securing the permit/any unauthorized changes are made to the site/any unauthorized changes are made in the installation of the system

Owner Anthony D. Tagner

Improvement Permit by date 2/13/96

Existing System Inspection by date 2/13/96

Authorization to Construct

Installed by

Certificate of Completion by date

Operation Permit by R. C. Moore date 2-22-96

INSPECTION COPY (FINAL) GREEN OWNER COPY (FINAL) YELLOW INSPECTION COPY (INITIAL) PINK OWNER COPY (INITIAL)

Authorization To Construct is Valid 5 years from date of issuance.

519208