IREDELL COUNTY HEALTH DEPARTMENT

STATESVILLE 704-878-5305 MOORESVILLE 704-664-5281

6/16/14

IMPROVEMENT PERMIT / CERTIFICATE OF COMPLETION / OPERATION PERMIT / EXISTING SYSTEM INSPECTION

PROPERTY DESCRIPTION NO. 23896 DATE 6-8-96 TAX MAP NO. 11L-2-A-43 Watershed: ☐ Yes ☑ No

OWNER OR CONTRACTOR VANCE G. EVERETT PHONE: Business Home 948-7273

ADDRESS 11401 STATESVILLE ROAD, HUNTERSVILLE, NC 28078

LOCATION COOL SPRINGS ROAD, TR RIVER HILL RD, TL SOUTHWAY LANE, ON RIGHT BEFORE END

SUBDIVISION COOLWOOD BLOCK / SECTION II LOT 43 LOT AREA 164 x 200 SITE CLASS PS DESIGN FLOW 360 L.T.A.R. 0.25 GPD/FT2

Septic Tank: 1000 Gallons; STB 821 Date 5-9-96

Pump Tank: ____ Gallons; PT ____ Date ____

Pump Make: ____ Model ____ Serial No. ____

Nitrification Field: No Fields 1 Square Feet 1440 Linear Feet 480

No Lines 4 Trench Width 36" Max Trench Bottom Depth 36" Gravel Depth 12"

☑ New System ☐ Repair System Type: I (II) III, IV, V, VI

System Description: CONV. GRAVITY

Repair System Description: CONV. GRAVITY

Maintenance Agreement Required: ☐ Yes ☑ No

☐ House/Mod. Home ☑ Mobile Home ☐ Business ☐ Other

No. Bedrooms 3 No. Bathrooms 2 No. Employees ____


☐ Slab ☑ Crawl Space ☐ Basement w/plumbing ☐ Basement wo/plumbing

Water Supply: ☐ Individual ☐ Community ☑ Public

Comments:

Comments:

INITIAL SITE SKETCH

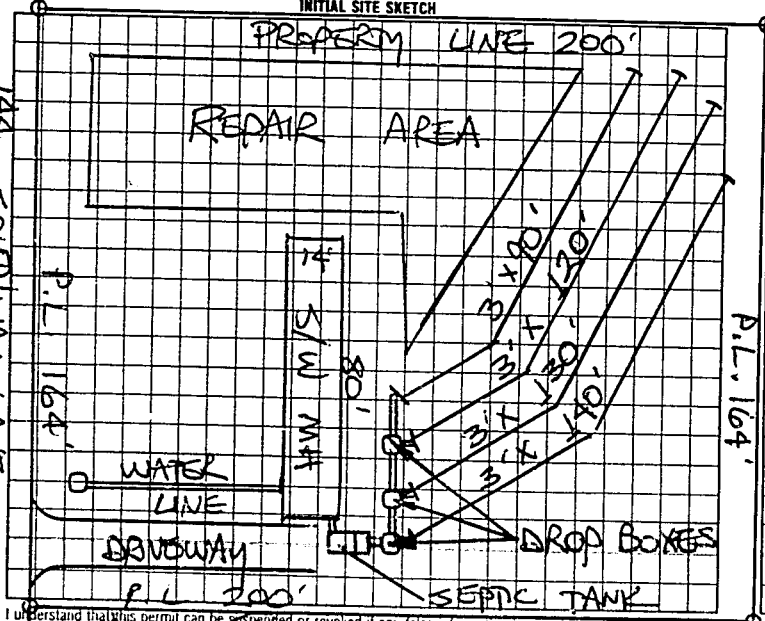

AS BUILT SKETCH

Same as initial sketch

I understand that this permit can be suspended or revoked if any false information is supplied toward securing the permit, any unauthorized changes are made to the site/any unauthorized changes are made in the installation of the system.

Authorization to Construct is valid five (5) years from date of issuance. Improvement Permit has no expiration date.

Signed: [signature]

Improvement Permit by: STEVE HEDRICK date 6-8-96

AUTHORIZATION TO CONSTRUCT: STEVE HEDRICK date 6-8-96

Installed by: G & M Enterprizes

Certificate of Completion by: ____ date ____

Operation Permit by: R. C. Moore date 6-17-96

HEALTH DEPT COPY: WHITE — INSPECTION COPY (FINAL): GREEN — OWNER COPY (FINAL): YELLOW — INSPECTION COPY (INITIAL): PINK — OWNER COPY (INITIAL): GOLD

2600000