11:00

IREDELL COUNTY HEALTH DEPARTMENT

STATESVILLE 704-878-5305 MOORESVILLE 704-664-5281

IMPROVEMENT PERMIT / CERTIFICATE OF COMPLETION / OPERATION PERMIT / EXISTING SYSTEM INSPECTION

PROPERTY DESCRIPTION NO. 24800 DATE 9-10-96 TAX MAP NO. 11L-2-A-4 Watershed: ☐ Yes ☐ No

OWNER OR CONTRACTOR Paul Sprinkle PHONE: Business 662 8436 Home

ADDRESS PO Box 1101 Mooresville 28115

LOCATION 645 TR Oldmocksville TR Coolsp. TR Riverhill 3rd lot left

SUBDIVISION Coolwood BLOCK / SECTION LOT 4 LOT AREA 145X225 SITE CLASS. PS DESIGN FLOW 360 L.T.A.R. .3

Septic Tank: 1000 Gallons; STB 794 Date 10-18-95 ☑ New System ☐ Repair System Type: I II III, IV, V, VI

Pump Tank: Gallons; PT Date

Pump Make: Model Serial No.

Nitrification Field: No Fields 1 Square Feet 1200 Linear Feet 400

No Lines 3 Trench Width 36" Max Trench Bottom Depth 34" Gravel Depth 12"

System Description: Conv. Gravity

Repair System Description: Conv. Gravity

Maintenance Agreement Required: ☐ Yes ☑ No

☐ House/Mod. Home No. Bedrooms 3

☑ Mobile Home No. Bathrooms 2

☐ Business No. Employees

☐ Other


☐ Slab ☑ Crawl Space ☐ Basement w/plumbing ☐ Basement wo/plumbing

Water Supply: ☐ Individual ☐ Community ☑ Public


Comments:

Comments:

INITIAL SITE SKETCH

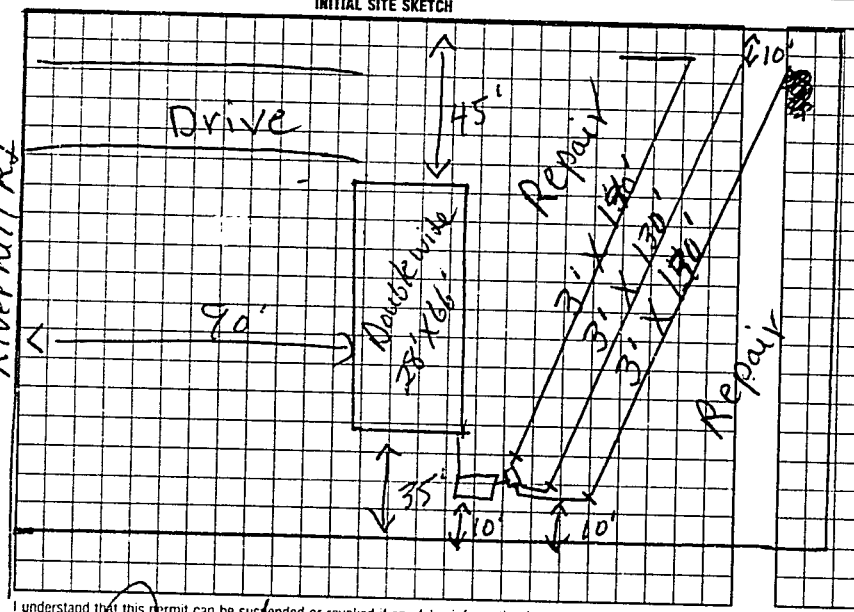

AS BUILT SKETCH

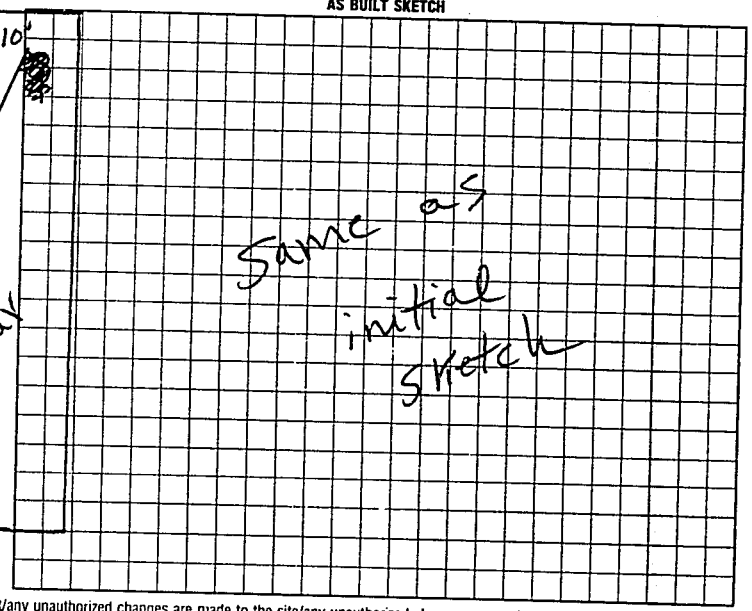

I understand that this permit can be suspended or revoked if any false information is supplied toward securing the permit/any unauthorized changes are made to the site/any unauthorized changes are made in the installation of the system.

Signed: Paul Sprinkle

Improvement Permit by: R.C. moore date 9-10-96

Existing System Inspection: Authorization to court R.C. moore date 9-10-96

Installed by: A-1 Backhoe

Certificate of Completion by: date

Operation Permit by: R.C. moore date 9-19-96

HEALTH DEPT. COPY: WHITE INSPECTION COPY (FINAL): GREEN OWNER COPY (FINAL): YELLOW Authorization to court Expires 60 mon. from I.S. INSPECTION COPY (INITIAL): PINK OWNER COPY (INITIAL): GOLD