IREDELL COUNTY HEALTH DEPARTMENT

STATESVILLE 704-878-5305 MOORESVILLE 704-664-5281

9:30 Gary miller 56277

IMPROVEMENT PERMIT / CERTIFICATE OF COMPLETION / OPERATION PERMIT / EXISTING SYSTEM INSPECTION

PROPERTY DESCRIPTION NO. 21330 DATE 6-13-95 TAX MAP NO. 116-2-A-8 Watershed: ☐ Yes ☑ No

OWNER OR CONTRACTOR William R. Street PHONE: Business Home 528 4122

ADDRESS 1040 Charlotte HWY Troutman

LOCATION 64 E TL Sivann Rd TR Riverhill TR cool Sp. 3rd lot RT

SUBDIVISION Coolwood BLOCK / SECTION LOT 8 LOT AREA 155X214 SITE CLASS. P3 DESIGN FLOW 360 L.T.A.R. .3

Septic Tank: 1000 Gallons; STB 821 Date 5-12-95

Pump Tank: Gallons; PT Date

Pump Make: Model Serial No.

Nitrification Field: No Fields 1 Square Feet 1200 Linear Feet 400

No Lines 3 Trench Width 36" Max Trench Bottom Depth 36" Gravel Depth 12"

☑ New System ☐ Repair System Type: I ☑ III, IV, V, VI

System Description: Conv. Gravity

Repair System Description:

Maintenance Agreement Required: ☐ Yes ☑ No

☐ House/Mod. Home No. Bedrooms 3

☑ Mobile Home No. Bathrooms 2

☐ Business No. Employees

☐ Other


☐ Slab ☑ Crawl Space ☐ Basement w/plumbing ☐ Basement wo/plumbing

Water Supply: ☑ Individual ☐ Community ☐ Public


Comments:

Comments: mobile Home was not on site at time of this inspection. Keep with Proper distance from mH as shown on sketch. public water line has been installed since lay-out was made could be used instead of well.

INITIAL SITE SKETCH

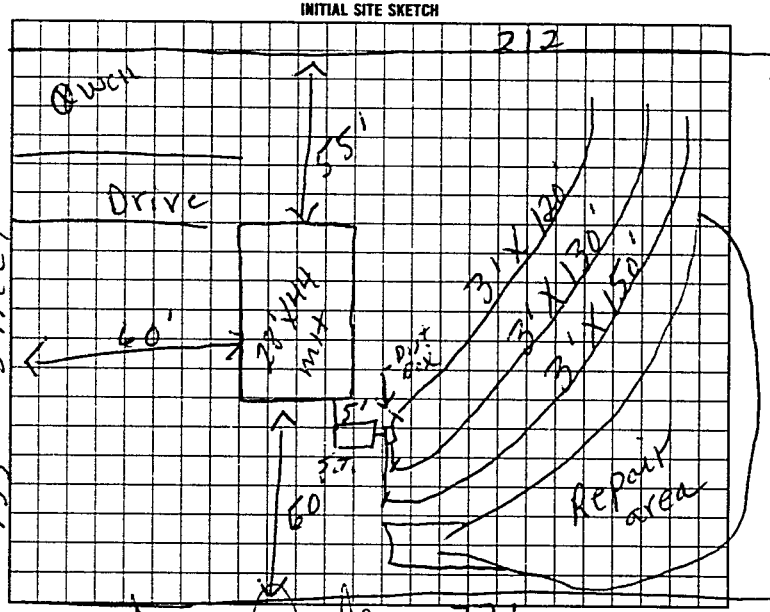

AS BUILT SKETCH

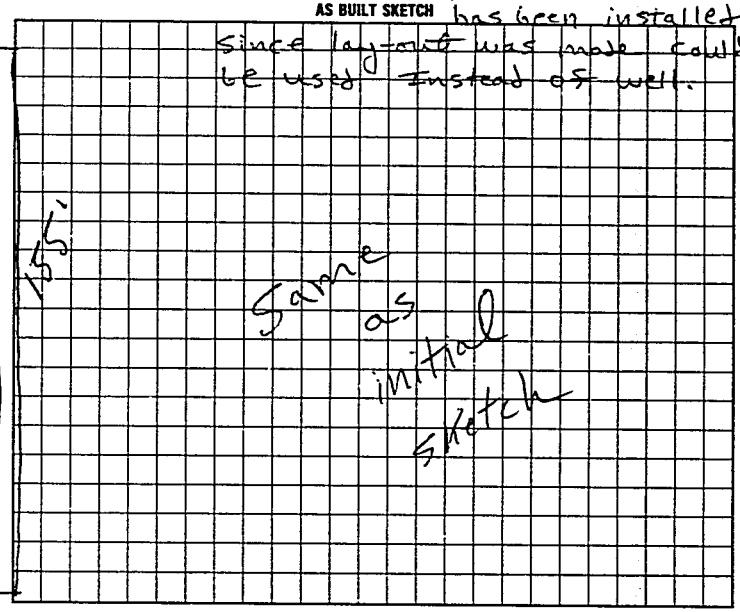

I understand that this permit can be suspended or revoked if any false information is supplied toward securing the permit/any unauthorized changes are made to the site/any unauthorized changes are made in the installation of the system. Improvement Permit is valid for 60 months from date of issuance.

Signed:

Improvement Permit by: L. C. Moore date 6-13-95

Existing System Inspection by: date

Installed by: G+M Enterprises

Certificate of Completion by: L. C. Moore date 6-30-95

Operation Permit by: date

HEALTH DEPT. COPY: WHITE INSPECTION COPY (FINAL): GREEN OWNER COPY (FINAL): YELLOW INSPECTION COPY (INITIAL): PINK OWNER COPY (INITIAL): GOLD

56800