63632

IREDELL COUNTY HEALTH DEPARTMENT

STATESVILLE 704-878-5305 MOORESVILLE 704-664-5281

IMPROVEMENT PERMIT / CERTIFICATE OF COMPLETION / OPERATION PERMIT / EXISTING SYSTEM INSPECTION

PROPERTY DESCRIPTION NO. 25096 DATE 10-1-96 TAX MAP NO. 116-2-A-36 Watershed: ☐ Yes ☐ No

OWNER OR CONTRACTOR Lisa C. Phillips PHONE: Business _____ Home 873-4439

ADDRESS 150 Rejoice Ln Statesville

LOCATION Riverhill Rd TR Southway TL Northfield 3rd lot Rt

SUBDIVISION Coolwood BLOCK / SECTION _____ LOT 36 LOT AREA 3/4 acre+ SITE CLASS. PS DESIGN FLOW 360 L.T.A.R. 1.3

Septic Tank: 1000 Gallons; STB _____ Date _____

Pump Tank: _____ Gallons; PT _____ Date _____

Pump Make: _____ Model _____ Serial No. _____

Nitrification Field: No Fields 1 Square Feet 1200 Linear Feet 400

No Lines 4 Trench Width 3½' Max Trench Bottom Depth 36" Gravel Depth 12"

☑ New System ☐ Repair System Type: I II III IV V VI

System Description: Conv. Gravity

Repair System Description: Gravity chambers

Maintenance Agreement Required: ☐ Yes ☐ No

☐ House/Mod. Home No. Bedrooms 3

☑ Mobile Home No. Bathrooms 2

☐ Business No. Employees ____

☐ Other _____


☐ Slab ☑ Crawl Space ☐ Basement w/plumbing ☐ Basement wo/plumbing

Water Supply: ☐ Individual ☐ Community ☑ Public


Comments

Comments: Mobile Home Not on site time of inspection

INITIAL SITE SKETCH

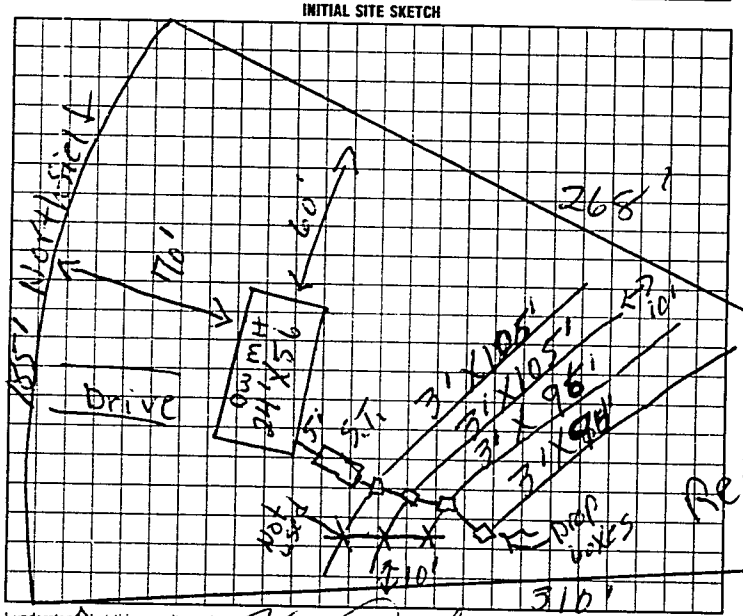

AS BUILT SKETCH

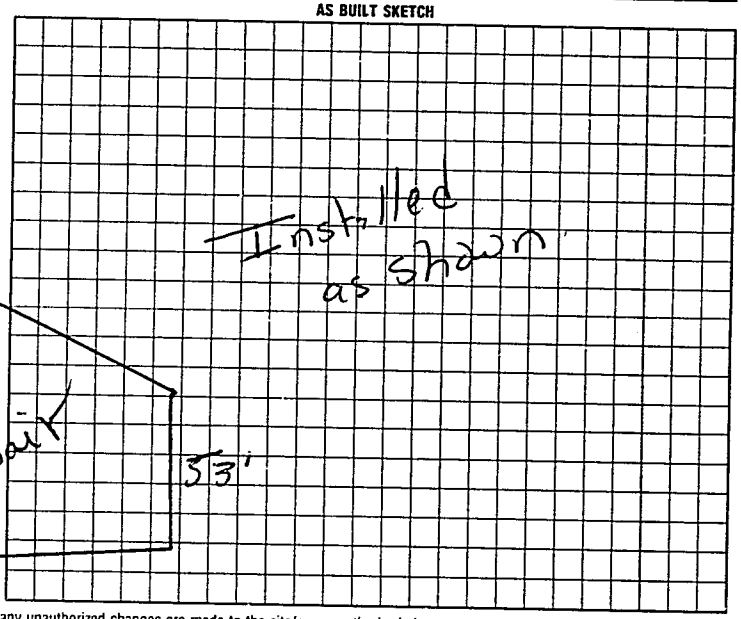

I understand that this permit can be suspended or revoked if any false information is suppiied toward securing the permit/any unauthorized changes are made to the site/any unauthorized changes are made in the installation of the system.

Signed: Jerry A. Caudle

Improvement Permit by: E.C. Moore date 10-1-96

Authorization to Existing System Inspection by: E.C. Moore date 10-1-96

Installed by: O+M Enterprise

Certificate of Completion by: _____ date _____

Operation Permit by: M+CO+ RS date 10-11-96

WHITE: HEALTH DEPT. COPY; INSPECTION COPY (FINAL): GREEN; OWNER COPY (FINAL): YELLOW; INSPECTION COPY (INITIAL): PINK; OWNER COPY (INITIAL): GOLD

Authorization to Count to COUNT

Expires 6 mos from issue

66L100