IREDELL COUNTY HEALTH DEPARTMENT

STATESVILLE 704-878-5305 MOORESVILLE 704-664-5281

IMPROVEMENT PERMIT / AUTHORIZATION TO CONSTRUCT / OPERATION PERMIT / EXISTING SYSTEM INSPECTION

PERMIT# 110248 PIN# 4777-72-7146 DATE 12-20-02

OWNER OR CONTRACTOR RICHARD TURNER PHONE: Business 704-528-9336 Home

ADDRESS 1018 CHARLOTTE HWY TROUTMAN, NC 28166

LOCATION RIVERHILL RD, (R) COOLWOOD (L) NORTHFIELD LOT # 36 ON RT IN CURVE

SUBDIVISION COOLWOOD BLOCK / SECTION 2 LOT 36 LOT AREA ± 0.68AC SITE CLASS. PS DESIGN FLOW 360 L.T.A.R. .3

EXISTING

Septic Tank: 1000 Gallons; STB Date

Pump Tank: Gallons; PT Date

Pump Make: Model Serial No.

Nitrification Field: No Fields 1 Square Feet 1200' Linear Feet 400'

No Lines 4 Trench Width 36" Max Trench Bottom Depth 36" Gravel Depth 12"

~~New System~~ Repair System Type: I, (II), III, IV, V, VI

System Description: CONV GRAV

Repair System Description: GRAV 25% INCR

Maintenance Agreement Required: ☐ Yes ☒ No

☐ House/Mod. Home ☒ Mobile Home ☐ Business ☐ Other

No. Bedrooms 3 No. Bathrooms 2 No. Employees

☐ Slab ☒ Crawl Space ☐ Basement w/plumbing ☐ Basement wo/plumbing


Water Supply: ☐ Individual ☒ Public ☐ Community

Comments:/Conditions: (1) HOME NOT ON SITE AT TIME OF CHECK (2) MAINTAIN SEEDBALLS


Comments:/Conditions:

(1)

INITIAL SITE SKETCH

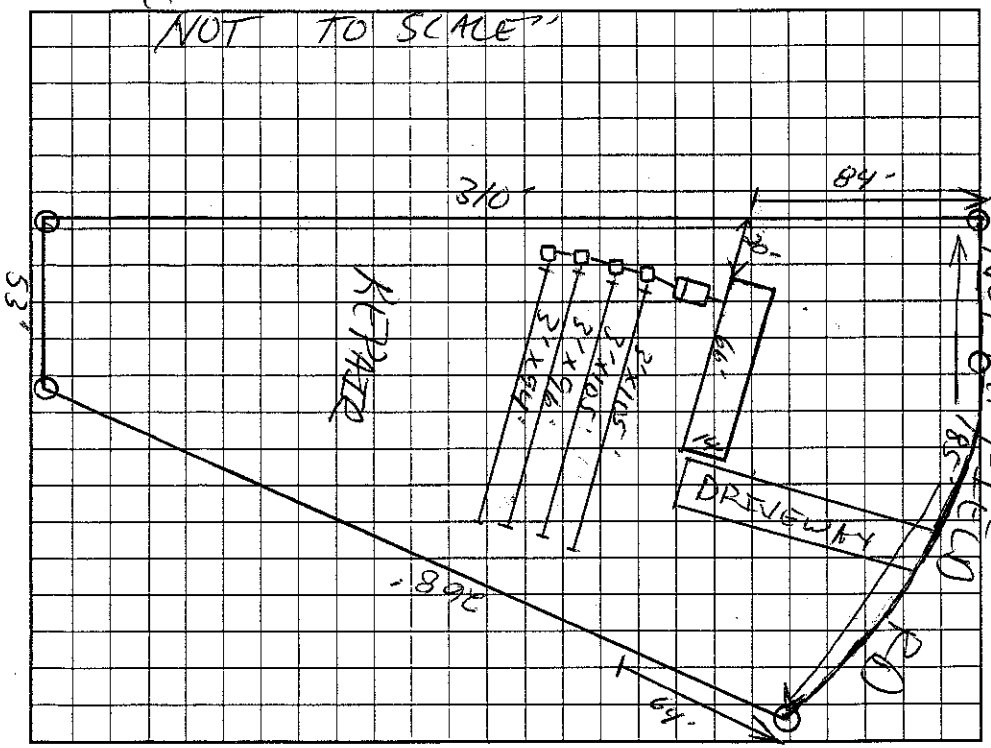

AS BUILT SKETCH

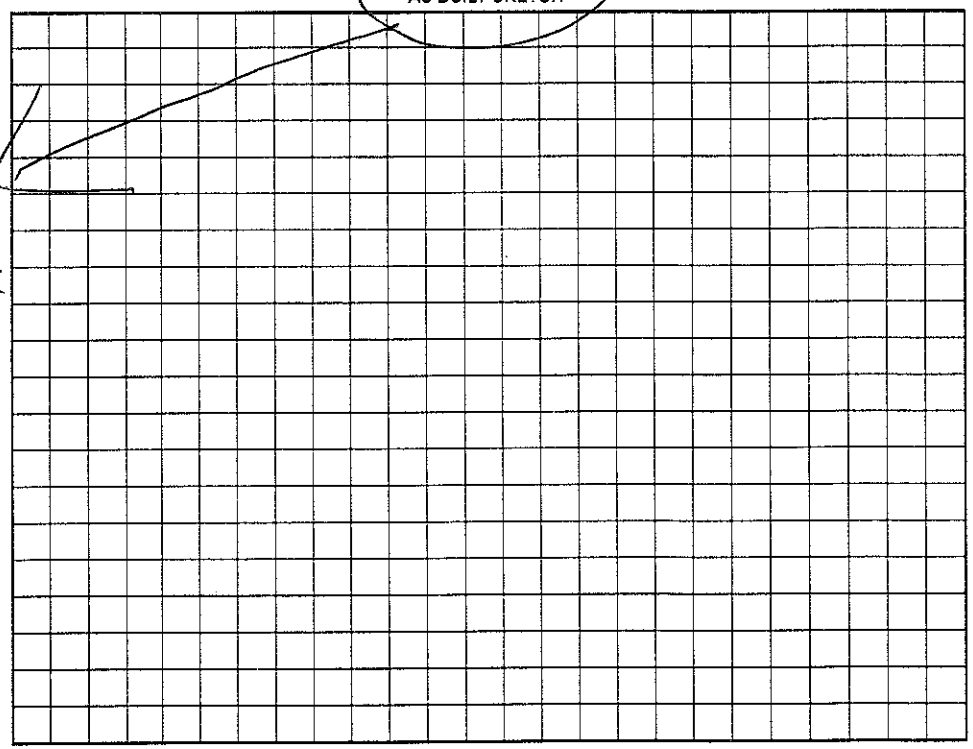

Permit can be suspended or revoked if any false information is supplied toward securing the permit/any unauthorized changes are made to the site/any unauthorized changes are made in the installation of the system. Improvement Permit with plat valid without expiration. Improvement Permit with site plan valid for sixty months. Authorization to Construct is valid for a period equal to that of Improvement Permit – not to exceed sixty months.

Signed: Jamie R. Graham date 12-20-02 Installed by:

Improvement Permit by: date 12-20-02 Operation Permit by: date

Authorization to Construct by: date 12-20-02 Existing System Inspection by: date 01-10-03

HEALTH DEPT. COPY: WHITE OWNER COPY (FINAL): YELLOW OWNER COPY (INITIAL): PINK