Scott Beattie on Computer

IREDELL COUNTY HEALTH DEPARTMENT

STATESVILLE 704-878-5305 MOORESVILLE 704-664-5281

IMPROVEMENT PERMIT / CERTIFICATE OF COMPLETION / OPERATION PERMIT / EXISTING SYSTEM INSPECTION

PROPERTY DESCRIPTION NO 72249 DATE 9-27-95 TAX MAP NO. 116-2-A-10 Watershed: ☐ Yes ☐ No

OWNER OR CONTRACTOR Piedmont Housing PHONE: Business 528-7120 Home

ADDRESS 1040 Charlotte Hwy Troutman, N.C.

LOCATION 64E To Riverhill Rd TR Coolsp, Rt 1 Lot on Rt

SUBDIVISION Coolwood BLOCK / SECTION LOT 10 LOT AREA 155'X210' SITE CLASS PS DESIGN FLOW 360 L.T.A.R. .3

Septic Tank: 1000 Gallons; STB 821 Date 9-6-95

Pump Tank: Gallons; PT Date

Pump Make: Model Serial No. 533

Nitrification Field: No Fields 1 Square Feet 1600 Linear Feet

No Lines 5 Trench Width 36" Max Trench Bottom Depth 36" Gravel Depth 12"

☐ New System ☐ Repair System Type: I, II, III, IV, V, VI

System Description: Conv. Gravity

Repair System Description: " "

Maintenance Agreement Required: ☐ Yes ☑ No

☐ House/Mod. Home No. Bedrooms 4

☐ Mobile Home No. Bathrooms 2

☐ Business No. Employees

☐ Other

☐ Slab ☑ Crawl Space ☐ Basement w/plumbing ☐ Basement wo/plumbing


Water Supply: ☐ Individual ☐ Community ☑ Public

Comments:

Lay-out Switched To 4 Bedroom 10-16-95 JCM

Comments:

INITIAL SITE SKETCH

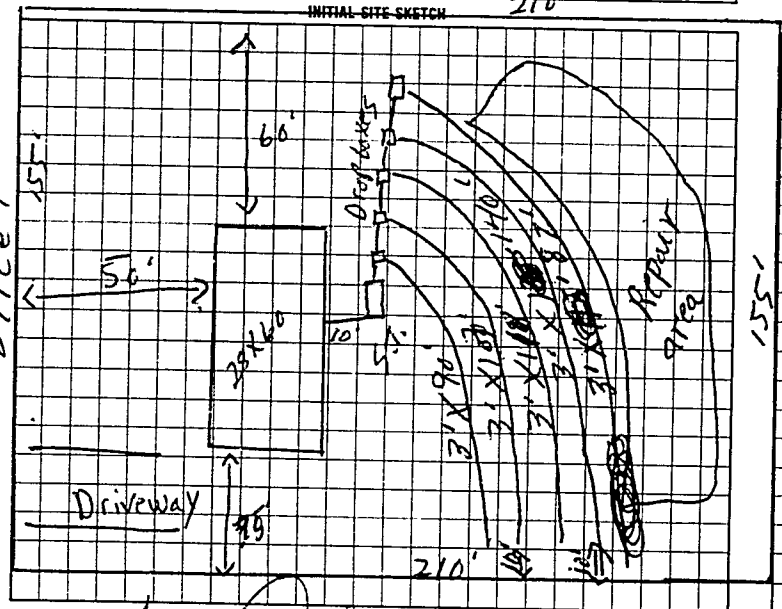

AS BUILT SKETCH

Same as initial Sketch

I understand that this permit can be suspended or revoked if any false information is supplied toward securing the permit/any unauthorized changes are made to the site/any unauthorized changes are made in the installation of the system.

Signed: Tony Cauthen, Sales

Improvement Permit by: E.C. Moore date 9-27-95

Existing System Inspection by date

Installed by: G & M Enterprizes

Certificate of Completion by: E.C. Moore date 10-18-95

Operation Permit by E.C. Moore date 10-18-95

HEALTH DEPT COPY WHITE INSPECTION COPY (FINAL) GREEN OWNER COPY (FINAL) YELLOW INSPECTION COPY (INITIAL) PINK OWNER COPY (INITIAL) GOLD

29700