Scott Beattie on Computer

IREDELL COUNTY HEALTH DEPARTMENT

STATESVILLE 704-878-5305 MOORESVILLE 704-664-5281

IMPROVEMENT PERMIT / CERTIFICATE OF COMPLETION / OPERATION PERMIT / EXISTING SYSTEM INSPECTION

PROPERTY DESCRIPTION NO 72249 DATE 9-27-95 TAX MAP NO. 116-2-A-10 Watershed: ☐ Yes ☐ No

OWNER OR CONTRACTOR Piedmont Housing PHONE: Business 5256120 Home

ADDRESS 1040 Charlotte Hwy Troutman, N.C.

LOCATION 64E To Riverhill Rd TR coolsp, Rt 3rd lot on Rt

SUBDIVISION Cedarwood BLOCK / SECTION LOT 10 LOT AREA 155'x210' SITE CLASS PS DESIGN FLOW 360 L.T.A.R. .3

Septic Tank: 1000 Gallons: STB 821 Date 9-6-95

Pump Tank: Gallons: PT Date

Pump Make: Model Serial No. 533

Nitrification Field: No Fields 1 Square Feet 1600 Linear Feet

No Lines 5 Trench Width 36" Max Trench Bottom Depth 36" Gravel Depth 12"

☐ New System ☐ Repair System Type: I, II, III, IV, V, VI

System Description: Conv. Gravity

Repair System Description: " "

Maintenance Agreement Required: ☐ Yes ☒ No

☐ House/Mod. Home ☐ Mobile Home ☐ Business ☐ Other

No. Bedrooms 4 No. Bathrooms 2 No. Employees

☐ Slab ☒ Crawl Space ☐ Basement w/plumbing ☐ Basement wo/plumbing


Water Supply: ☐ Individual ☐ Community ☒ Public

Comments:


lay-out switched To 4 Bedroom 10-16-95 JCM

Comments:

INITIAL SITE SKETCH

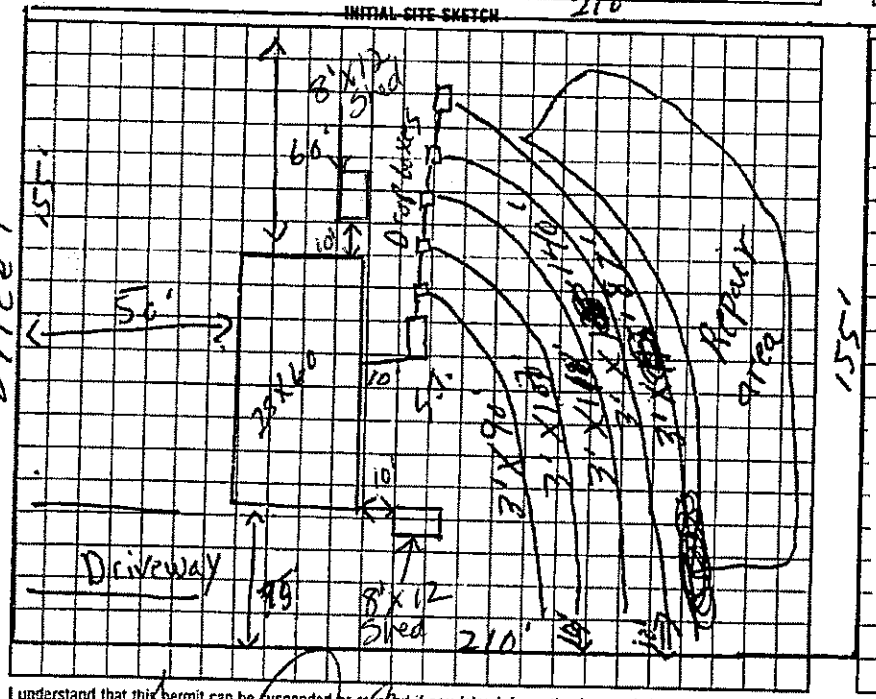

AS BUILT SKETCH

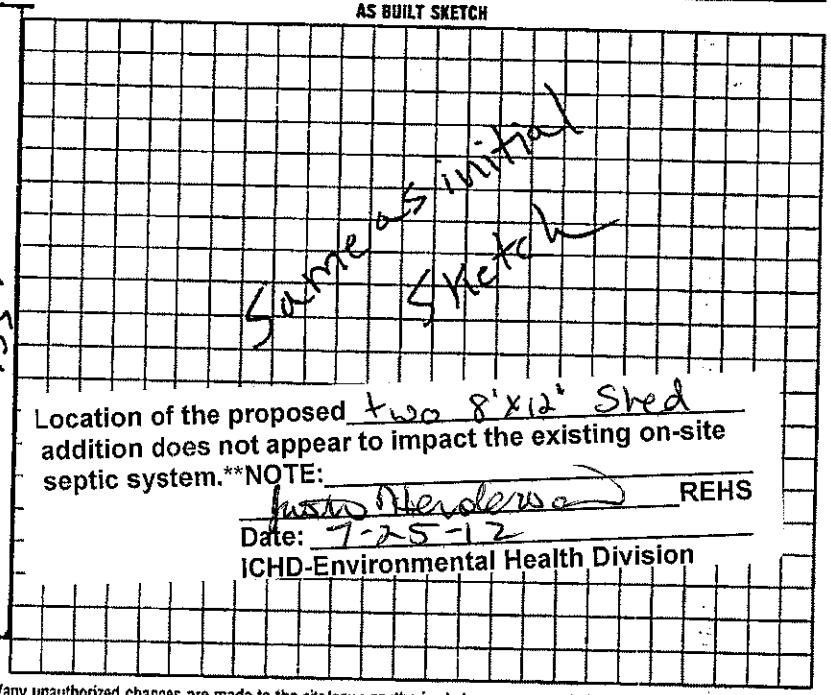

Location of the proposed two 8'x12' Shed addition does not appear to impact the existing on-site septic system.**NOTE:

Justin Henderson REHS

Date: 7-25-12

ICHD-Environmental Health Division

I understand that this permit can be suspended or revoked if any false information is supplied toward securing the permit/any unauthorized changes are made to the site/any unauthorized changes are made in the installation of the system.

Signed: Jerry Carothers, Sales

Improvement Permit by: P.C. moore date 9-27-95

Existing System Inspection by Date

Installed by: G & M Enterprizes

Certificate of Completion by: P.C. moore date 10-18-95

Operation Permit by P.C. moore date 10-18-95

HEALTH DEPT COPY WHITE INSPECTION COPY (FINAL) GREEN OWNER COPY (FINAL) YELLOW INSPECTION COPY (INITIAL) PINK OWNER COPY (INITIAL) GOLD