Scott Beattie on Computer

IREDELL COUNTY HEALTH DEPARTMENT

STATESVILLE 704-878-5305 MOORESVILLE 704-664-5281

IMPROVEMENT PERMIT / CERTIFICATE OF COMPLETION / OPERATION PERMIT / EXISTING SYSTEM INSPECTION

PROPERTY DESCRIPTION NO 7249 DATE 9-27-95 TAX MAP NO 116-2-A-10 Watershed: ☐ Yes ☐ No

OWNER OR CONTRACTOR Piedmont Housing PHONE: Business 528-7120 Home

ADDRESS 1040 Charlotte Hwy Troutman, N.C.

LOCATION 64E TO Riverhill PT TR Cool Sp RT 3 lot on RT

SUBDIVISION Coolwood BLOCK / SECTION LOT 10 LOT AREA 155'x210' SITE CLASS PS DESIGN FLOW 360 L.T.A.R. .3

Septic Tank: 1000 Gallons; STB 821 Date 9-6-95

Pump Tank: Gallons; PT Date

Pump Make: Model Serial No. 533

Nitrification Field: No Fields 1 Square Feet 1600 Linear Feet

No Lines 5 Trench Width 36" Max Trench Bottom Depth 36" Gravel Depth 12"

☐ New System ☐ Repair System Type: I, II, III, IV, V, VI

System Description: Conv. Gravity

Repair System Description:

Maintenance Agreement Required: ☐ Yes ☒ No

☐ House/Mod. Home ☐ Mobile Home ☐ Business ☐ Other

No. Bedrooms 4 No. Bathrooms 2 No. Employees

☐ Slab ☐ Crawl Space ☐ Basement w/plumbing ☐ Basement wo/plumbing


Water Supply: ☐ Individual ☐ Community ☒ Public

Comments:


Lay-out Switched To 4 Bedroom 10-16-95 JCM

Comments:

INITIAL SITE SKETCH

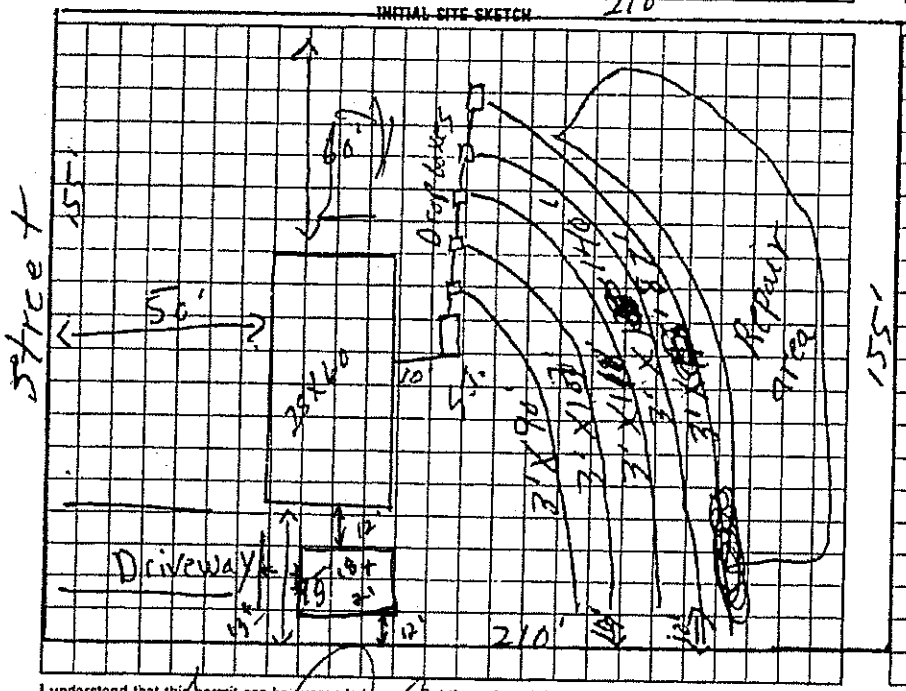

AS BUILT SKETCH

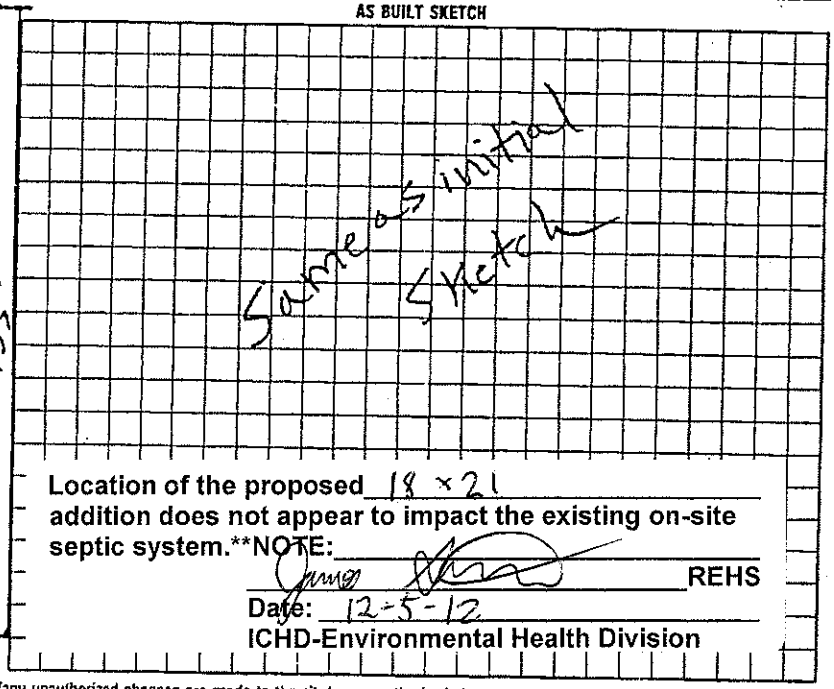

Location of the proposed 18 x 21 addition does not appear to impact the existing on-site septic system.**NOTE:

REHS

Date: 12-5-12

ICHD-Environmental Health Division

I understand that this permit can be suspended or revoked if any false information is supplied toward securing the permit/any unauthorized changes are made to the site/any unauthorized changes are made in the installation of the system.

Signed: Tony Sales

Improvement Permit by: P. C. Moore date 9-27-95

Existing System Inspection by date

Installed by: G & M Enterprizes

Certificate of Completion by: date 10-18-95

Operation Permit by P. C. Moore date 10-18-95

HEALTH DEPT COPY WHITE INSPECTION COPY (FINAL) GREEN OWNER COPY (FINAL) YELLOW INSPECTION COPY (INITIAL) PINK OWNER COPY (INITIAL) GOLD