528 7127

IREDELL COUNTY HEALTH DEPARTMENT

STATESVILLE 704-878-5305 MOORESVILLE 704-664-5281

IMPROVEMENT PERMIT / CERTIFICATE OF COMPLETION / OPERATION PERMIT / EXISTING SYSTEM INSPECTION

PROPERTY DESCRIPTION NO 22709 DATE 1-17-96 TAX MAP NO 116-2-A-34 Watershed: Yes No

OWNER OR CONTRACTOR ~~Lakeview Waterfront Properties~~ Withers Riverwalk Properties PHONE: Business 704-532-6527 Home

ADDRESS 5551 Monroe Rd Charlotte, N.C.

LOCATION 64E To Swann Rd TR Riverhill TR Southway Ln To Northfield 2nd lot RT

SUBDIVISION Cockwood BLOCK / SECTION LOT 34 LOT AREA 1.09 acres SITE CLASS PS DESIGN FLOW 360 L.T.A.R. .13

Septic Tank: 1000 Gallons: STB 821 Date 5-10-77
Pump Tank: Gallons: PT Date
Pump Make: Model Serial No
Nitrification Field: No Fields 1 Square Feet 1200 Linear Feet 400
No Lines 4 Trench Width 36" Max Trench Bottom Depth 36" Gravel Depth 12"

New System Repair System Type: I II III IV V
System Description: Conv. Gravity
Repair System Description
Maintenance Agreement Required: Yes No


House/Mod Home No Bedrooms 3
Mobile Home No Bathrooms 2
Business No Employees
Other
Slab Crawl Space Basement w/plumbing Basement wo/plumbing

Water Supply: Individual Community Public

Comments:

Comments

INITIAL SITE SKETCH

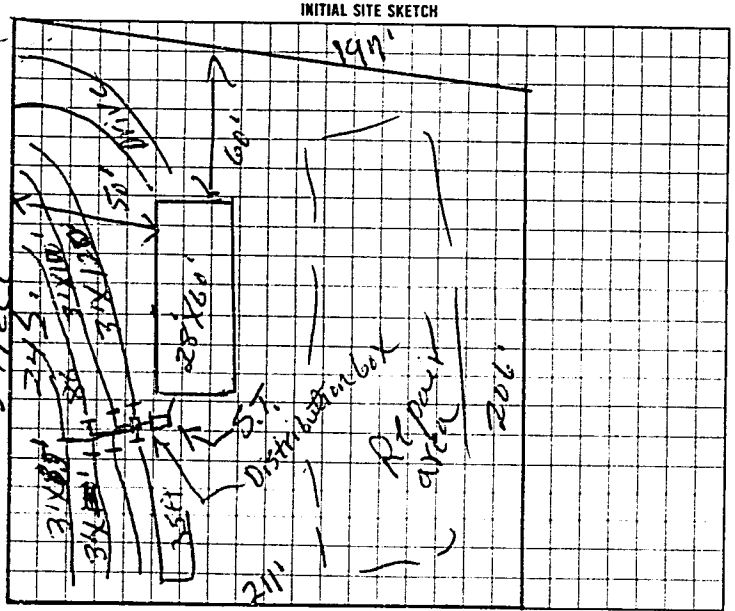

AS BUILT SKETCH

Installed as shown

I understand that this permit can be suspended or revoked if any false information is supplied toward securing the permit, any unauthorized changes are made to the site, any unauthorized changes are made in the installation of the system

Signed James J Barkley

Improvement Permit by ~~Authority of~~ R.C. Moore date 1-17-96

Certificate of Completion by R.C. Moore date 1-17-96

Operation Permit by

Installed by G & M Enterprises

date 6-18-97

~~Authority of~~ to Const. HEALTH DEPT COPY WHITE

Authorization to Const. INSPECTION COPY (FINAL) GREEN OWNER COPY (FINAL) YELLOW

Expires 60 mos from issue INSPECTION COPY (INITIAL) PINK OWNER COPY (INITIAL) GOLD

620000