4:00 6283

IREDELL COUNTY HEALTH DEPARTMENT

STATESVILLE 704-878-5305 MOORESVILLE 704-664-5281

IMPROVEMENT PERMIT / CERTIFICATE OF COMPLETION / OPERATION PERMIT / EXISTING SYSTEM INSPECTION

PROPERTY DESCRIPTION NO. 24553 DATE 8-12-96 TAX MAP NO. 116-2-A-56 Watershed: ☐ Yes ☑ No

OWNER OR CONTRACTOR Sherman White PHONE: Business _____ Home 872-0935

ADDRESS 221 E. Turner St Stvl.

LOCATION 64E Th Coolsp Rd Th Coolwood Dr. TR Northfield 4th lot Rt

SUBDIVISION Coolwood BLOCK / SECTION _____ LOT 56 LOT AREA 164X200 SITE CLASS. PS DESIGN FLOW 360 L.T.A.R. .27

Septic Tank: 1000 Gallons; STB 825 Date 7-11-96

Pump Tank: _____ Gallons; PT _____ Date _____

Pump Make: _____ Model _____ Serial No. _____

Nitrification Field: No Fields 1 Square Feet 1350 Linear Feet 450

No Lines 3 Trench Width 36" Max Trench Bottom Depth 36" Gravel Depth 12"

☑ New System ☐ Repair System Type: I, II, III, IV, V, VI

System Description: Conv. Gravity

Repair System Description: " "

Maintenance Agreement Required: ☐ Yes ☑ No

☐ House/Mod. Home No. Bedrooms 3

☑ Mobile Home No. Bathrooms 2

☐ Business No. Employees ____

☐ Other _____


☐ Slab ☑ Crawl Space ☐ Basement w/plumbing ☐ Basement wo/plumbing

Water Supply: ☐ Individual ☐ Community ☑ Public

Comments:

200'


INITIAL SITE SKETCH

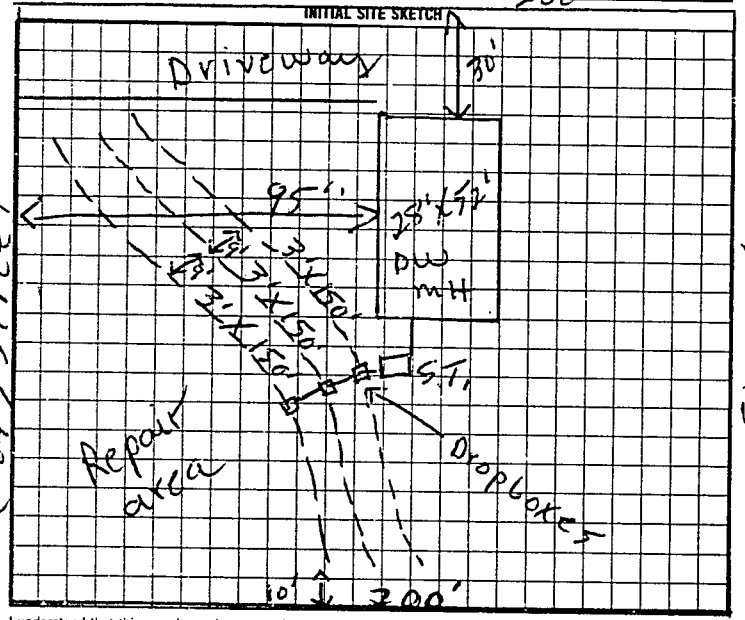

Comments:

Home moved Down slope Further than 50' - cut down on Repair area In Front remainder of repair will need to be pumped To back

AS BUILT SKETCH

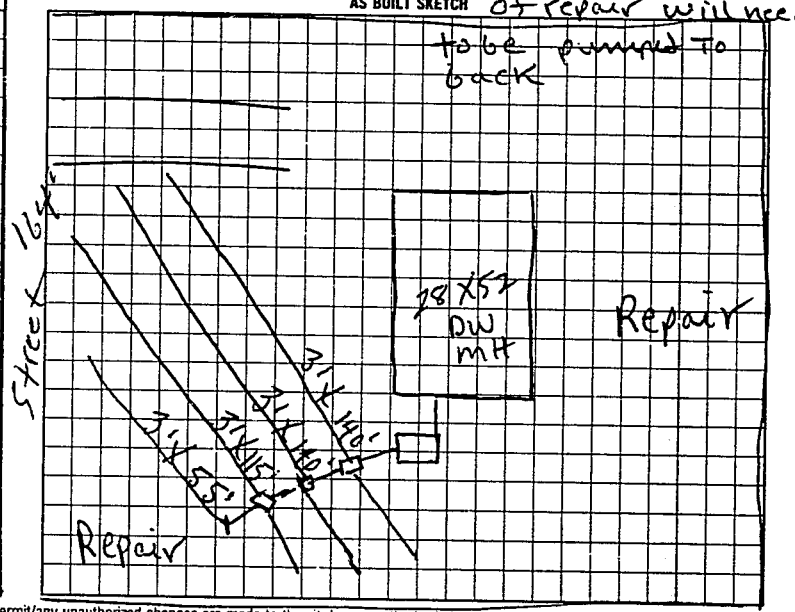

I understand that this permit can be suspended or revoked if any false information is supplied toward securing the permit/any unauthorized changes are made to the site/any unauthorized changes are made in the installation of the system.

Signed: X Maria L. White

Improvement Permit by: L.C. Moore date 8-12-96

Existing System Inspection by: L.C. Moore date 8-12-96

Installed by: Piedmont S.T. Co (China Grove)

Certificate of Completion by: _____ date _____

Operation Permit by: L.C. Moore date 9-17-96

Authorization to const.

HEALTH DEPT COPY WHITE INSPECTION COPY (FINAL) GREEN OWNER COPY (FINAL) YELLOW INSPECTION COPY (INITIAL) PINK OWNER COPY (INITIAL) GOLD

Authorization to const. Expires 60 mos from issue