IREDELL COUNTY HEALTH DEPARTMENT

STATESVILLE 704-878-5305 MOORESVILLE 704-664-5281

IMPROVEMENT PERMIT / AUTHORIZATION TO CONSTRUCT / OPERATION PERMIT / EXISTING SYSTEM INSPECTION

PERMIT # 1527169 PIN # 4777785845 DATE 9-29-08

OWNER or APPLICANT John Dunstater / Freedom Homes PHONE: Business Home: 704-871-2569

OWNER or APPLICANT ADDRESS 213 Bambi Lane Statesville, NC 28625

LOCATION / DIRECTIONS Old Mocksville, Rd to White Oak Chapel Rd Rt Chapel Rd to Bambi on left

SUBDIVISION Deer Park BLOCK / SECTION LOT # 106 LOT AREA 1.0 DESIGN FLOW 360 L.T.A.R. Best

Septic Tank Exist Gallons: STB Date

Pump Tank Gallons: P T Date

Pump Make Model Serial #

Nitrification Field No Fields No Lines 3 Linear Feet 300

Trench Width 24" Max. Trench Bottom Depth 30" Gravel Depth 12

☐ New System ☐ Repair ☐ Expansion System Type I II III IV V VI

System Description: Existing Gravel & Conventional

Repair System Description: Gravel - Conventional

Maintenance Agreement Required ☐ YES ☑ NO

☑ GRAVITY ☐ PRESSURE

☑ Residence No. Bedrooms 3

☐ Business No. Persons

☐ Other No. Employees

☐ Slab ☑ Crawl Space


☐ Basement w/plumbing ☐ Basement w/o plumbing

Water Supply: ☐ Private ☑ Public ☐ Community


Comments / Conditions

Comments / Conditions

INITIAL SITE SKETCH

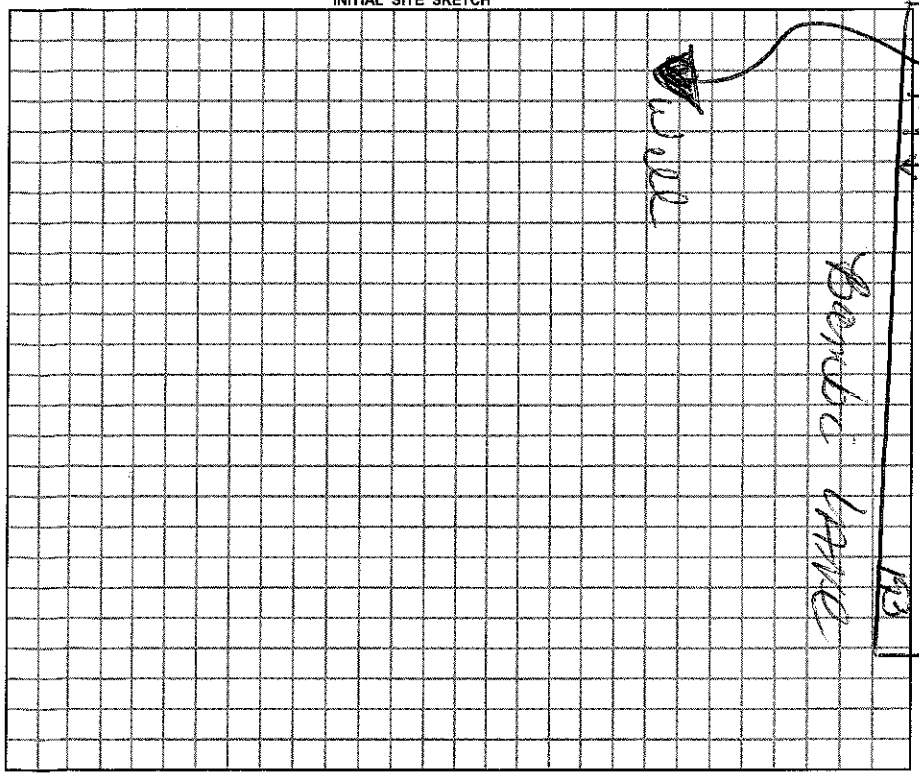

AS BUILT SKETCH

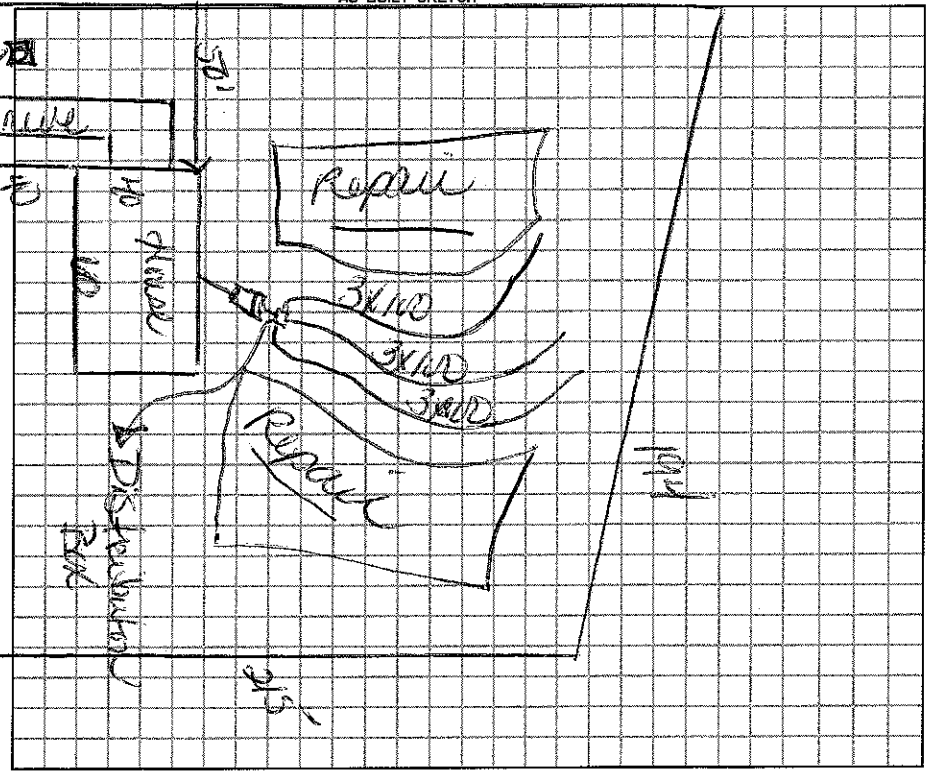

Permit can be suspended or revoked if any false information is supplied toward securing the permit / any unauthorized changes are made to the site / any unauthorized changes are made in the installation of the system.

☐ *IMPROVEMENT PERMIT w / plat valid without expiration.* ☐ *IMPROVEMENT PERMIT w / site plan valid for 60 mos.* ☐ *AUTHORIZATION TO CONSTRUCT valid for period equal to IMPROVEMENT PERMIT-not to exceed 60 mo.*

Owner / Applicant Signature: John Dunstater Date 10-1-08

Improvement Permit by: Date

Authorization to Construct by: Date

YOU SHOULD CONTACT A LOCATOR SERVICE PRIOR TO ANY EXCAVATION.

Installed by:

Operation Permit by: Date:

Existing System Inspected by: Date: 9-29-08

WHITE COPY Environmental Health YELLOW COPY (Final) Owner / Applicant PINK COPY (Initial) Owner / Applicant