IREDELL COUNTY HEALTH DEPARTMENT

STATESVILLE 704-878-5305 CI/CE MOORESVILLE 704-664-5281

IMPROVEMENT PERMIT / AUTHORIZATION TO CONSTRUCT / OPERATION PERMIT / EXISTING SYSTEM INSPECTION

PERMIT# 109 644 PIN# 4777-78-7790 DATE 11-8-02

OWNER OR CONTRACTOR FLEETWOOD HOMES PHONE: Business 704-872-0179 Home

ADDRESS 270 NORTHSIDE DR STATESVILLE NC 28677

LOCATION OLD MOORESVILLE 120 NORTH, (R) WHITE OAK TRAILER PARK, (L) DEER PARK, (L) AT BOX # 187

SUBDIVISION DEER PARK BLOCK / SECTION LOT 11 LOT AREA 1.00 AC SITE CLASS PS DESIGN FLOW 180 L.T.A.R. .35

Septic Tank: 1000 Gallons: STB EXISTING Date

Pump Tank: Gallons: PT Date

Pump Make: Model Serial No

Nitrification Field: No Fields Square Feet Linear Feet 120'

No Lines 2x60' Trench Width 36" Max Trench Bottom Depth 36" Gravel Depth N/A

X New System ☐ Repair System Type: I II (III) IV V VI

System Description: 6 PA-1 25% REDUCT

Repair System Description: LP PANEL

Maintenance Agreement Required: ☐ Yes X No

X House/Mod. Home No Bedrooms 4

☐ Mobile Home No. Bathrooms 2.5

☐ Business No. Employees

☐ Other


☐ Slab X Crawl Space ☐ Basement w/plumbing ☐ Basement wo/plumbing

Water Supply: ~~X~~ Individual ☐ Public ☐ Community


Comments/Conditions: (1) TIE INTO OLD BOX WITH NEW DIST BOX. USE SPEED LEVELERS (2) KEEP NEW 9 LINES 9' ON CENTER WITH OLD LINES, (3) MAINTAIN SETBACKS (4) SET UP NEW

Comments/Conditions: D/W IN SAME LOCATION AS OLD S/SYS. NEW 14' WIDTH WILL GO TOWARD THE FRONT ROAD. (5) INSTALL 2 LINES OF 25% REDUCTION 60' LONG

INITIAL SITE SKETCH

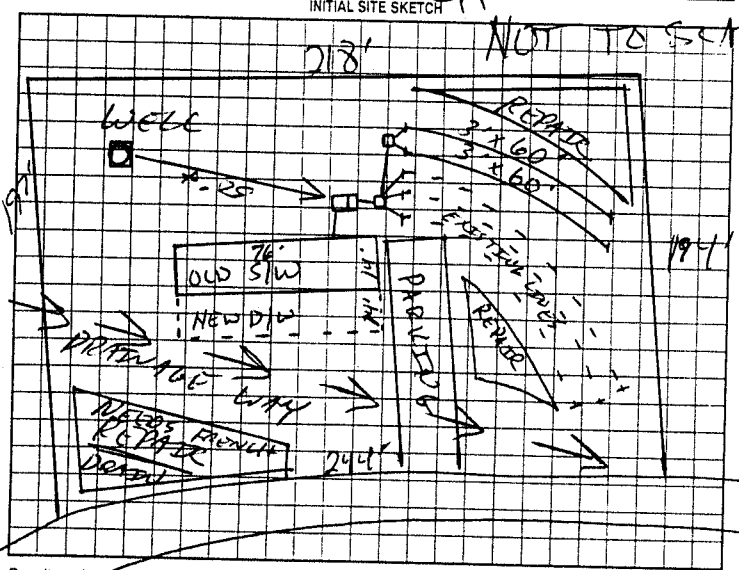

AS BUILT SKETCH 11/15/02 W/F (Ref Line + Top of Bank Line) ~~Floor Line~~

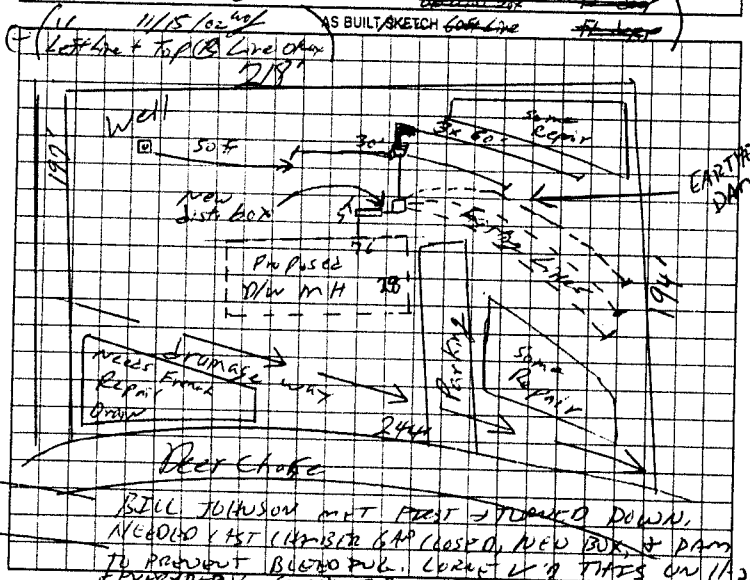

BILL JOHNSON MET FIRST STAKED DOWN. NEEDED VAST CHANGE GAP CLOSED, NEW BOX & PAN TO PREVENT BLOCKED PUB. CORRECT W/O THAT'S ON 11-25-02 COMPLETED. NEW LINES FLAG POST WITH SPEED LEVELER

Permit can be suspended or revoked if any false information is supplied toward securing the permit/any unauthorized changes are made to the site any unauthorized changes are made in the installation of the system. Improvement Permit with plat valid without expiration. Improvement Permit with site plan valid for sixty months. Authorization to Construct is valid for a period equal to that of Improvement Permit – not to exceed sixty months.

Signed: date

Improvement Permit by: date 11-2-02

Authorization to Construct by: date 11-8-02

Installed by Craig Thompson

Operation Permit by: date 11-25-02

Existing System Inspection by: date

HEALTH DEPT COPY WHITE OWNER COPY (FINAL) YELLOW OWNER COPY (INITIAL) PINK