3:00

IREDELL COUNTY HEALTH DEPARTMENT

STATESVILLE 704-878-5305 MOORESVILLE 704-664-5281

IMPROVEMENT PERMIT / CERTIFICATE OF COMPLETION / OPERATION PERMIT / EXISTING SYSTEM INSPECTION

PROPERTY DESCRIPTION NO. 22705 DATE 12-15-95 TAX MAP NO. 116-2-A-40 Watershed: ☐ Yes ☐ No

OWNER OR CONTRACTOR Karen Buttke PHONE: Business Home 878 6989

ADDRESS 147 Southway

LOCATION 64E TR Swann Rd at end TR Rivehill TR Southway before end Lgt

SUBDIVISION Coolwood BLOCK / SECTION LOT 40 LOT AREA 1.82 acres SITE CLASS. PS DESIGN FLOW 360 L.T.A.R. .127

Septic Tank: 1000 Gallons; STB 1012 Date 10-20-95

Pump Tank: Gallons; PT Date

Pump Make: Model Serial No.

Nitrification Field: No Fields 1 Square Feet 1350 Linear Feet 450

No Lines 3 Trench Width 36" Max Trench Bottom Depth 36" Gravel Depth 12"

☒ New System ☐ Repair System Type: I, II, III, IV, V, VI

System Description: Conv. Gravity

Repair System Description: Gravity Chambers

Maintenance Agreement Required: ☐ Yes ☐ No

☒ House/Mod. Home No. Bedrooms 3

☒ Mobile Home No. Bathrooms 2

☐ Business No. Employees

☐ Other


☐ Slab ☒ Crawl Space ☐ Basement w/plumbing ☐ Basement wo/plumbing

Water Supply: ☐ Individual ☐ Community ☒ Public

Comments:

25' R/W

INITIAL SITE SKETCH

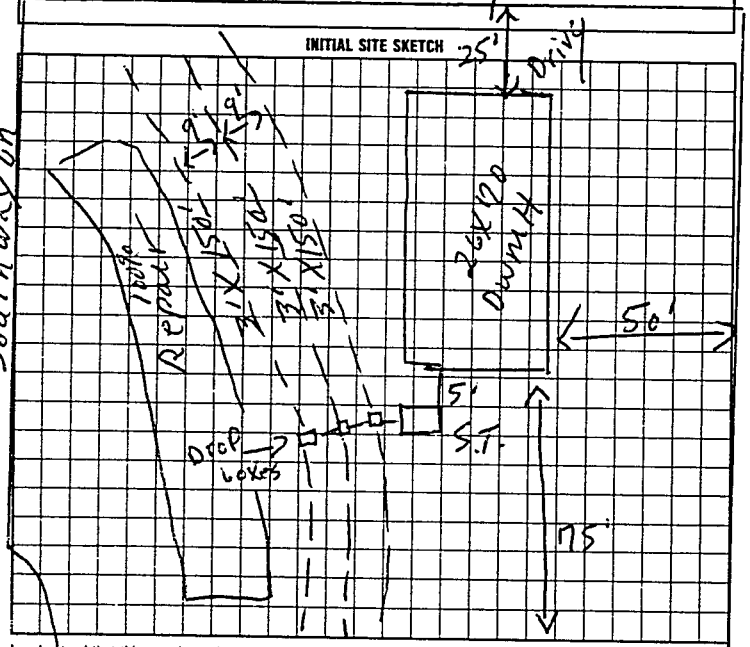

Southway Dr

Comments:

AS BUILT SKETCH

Same as initial Sketch

I understand that this permit can be suspended or revoked if any false information is supplied toward securing the permit/any unauthorized changes are made to the site/any unauthorized changes are made in the installation of the system.

Signed: [signature]

Improvement Permit by: J.C. Moore date 12-15-95

Existing System Inspection by: J.C. Moore date 12-15-95

Installed by: A-1 Backhoe

Certificate of Completion by: date

Operation Permit by: J.C. Moore date 2-13-01

authorization to const Expires 20 months from

HEALTH DEPT COPY: WHITE INSPECTION COPY (FINAL): GREEN OWNER COPY (FINAL): YELLOW INSPECTION COPY (INITIAL): PINK OWNER COPY (INITIAL): GOLD

19200