1:00 58758

IREDELL COUNTY HEALTH DEPARTMENT

STATESVILLE 704-878-5305 MOORESVILLE 704-664-5281

IMPROVEMENT PERMIT / CERTIFICATE OF COMPLETION / OPERATION PERMIT / EXISTING SYSTEM INSPECTION

PROPERTY DESCRIPTION NO. 22818 DATE 12-20-95 TAX MAP NO. 11L-2-A-26 Watershed: ☐ Yes ☑ No

OWNER OR CONTRACTOR Daniel F. Loomis PHONE: Business _____ Home 871-1328

ADDRESS 419 Salisbury Rd Statesville N.C.

LOCATION 64E TL Swann Rd TR Rivermill TR coolwood Sp. TR coolwood Towards end Rt (174 coolwood)

SUBDIVISION Coolwood BLOCK / SECTION _____ LOT 26 LOT AREA 1.38 acre SITE CLASS. PS DESIGN FLOW 480 L.T.A.R. .35

Septic Tank: 1000 Gallons; STB 1012 Date 10/8/95

Pump Tank: _____ Gallons; PT _____ Date _____

Pump Make: _____ Model _____ Serial No. _____

Nitrification Field: No Fields 1 Square Feet 1050 Linear Feet 350

No Lines 4 Trench Width 36" Max Trench Bottom Depth 36" Gravel Depth N/A

☑ New System ☐ Repair System Type: I, II, III, IV, V, VI

System Description: Gravity Chambers

Repair System Description: Pump to chambers

Maintenance Agreement Required: ☐ Yes ☐ No

☐ House/Mod. Home No. Bedrooms 4

☑ Mobile Home No. Bathrooms 2

☐ Business No. Employees _____

☐ Other _____

☐ Slab ☑ Crawl Space ☐ Basement w/plumbing ☐ Basement wo/plumbing


Water Supply: ☐ Individual ☐ Community ☑ Public

Comments:

170'

86'


INITIAL SITE SKETCH

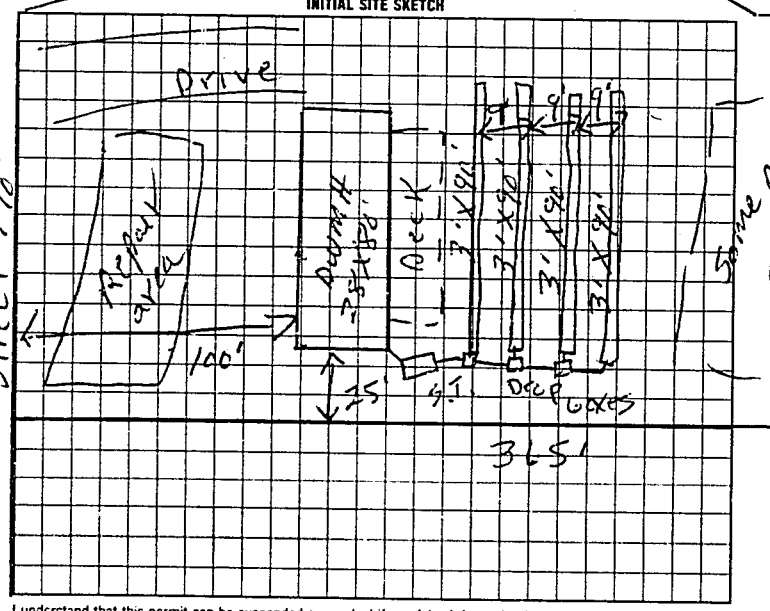

Comments:

170'

AS BUILT SKETCH

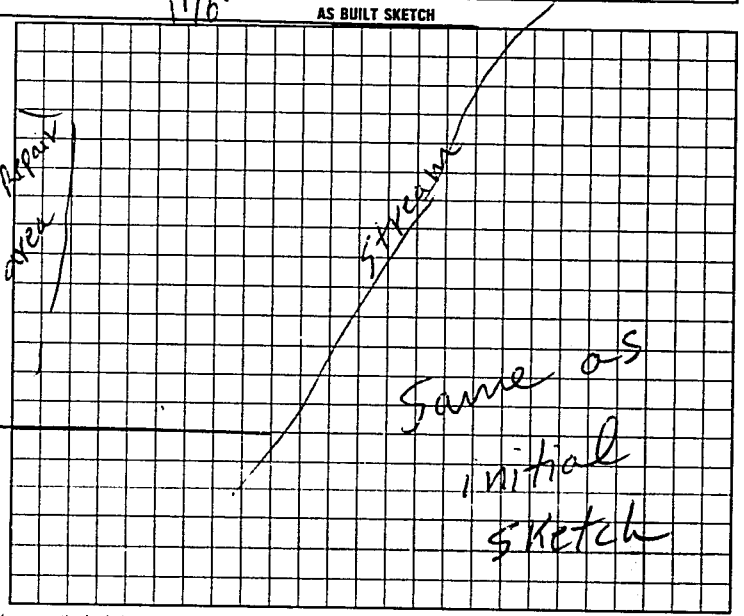

I understand that this permit can be suspended or revoked if any false information is supplied toward securing the permit/any unauthorized changes are made to the site/any unauthorized changes are made in the installation of the system.

Signed: x Daniel F. Loomis

Improvement Permit by: L.C. Moore date 12-20-95

Existing System Inspection by: L.C. Moore date 12-26-95

Installed by: Donald Fackrell

Certificate of Completion by: L.C. Moore date 1-25-96

Operation Permit by: _____ date _____

to CO. HEALTH DEPT. COPY: WHITE INSPECTION COPY (FINAL): GREEN OWNER COPY (FINAL): YELLOW INSPECTION COPY (INITIAL): PINK OWNER COPY (INITIAL): GOLD

Authorization to const. Expires 60 mos from issue date