IREDELL COUNTY HEALTH DEPARTMENT

STATESVILLE 704-878-5305 MOORESVILLE 704-664-5281

11:00 059902

IMPROVEMENT PERMIT / CERTIFICATE OF COMPLETION / OPERATION PERMIT / EXISTING SYSTEM INSPECTION

PROPERTY DESCRIPTION NO. 23256 DATE 3-13-96 TAX MAP NO. 116-2-A-23

OWNER OR CONTRACTOR Janet P. Forsythe PHONE: Business Watershed: Yes / No

ADDRESS 831 Popular St Apt 17 Salisbury, N.C. 28144 Home 704-639-1801

LOCATION 64E to coolsp Rd to coolwood Dr at ens lf.

SUBDIVISION Coolwood BLOCK / SECTION LOT 23 LOT AREA SITE CLASS PS DESIGN FLOW 360 L.T.A.R. .33

Septic Tank 1000 Gallons: STB 821 Date 2-22-96

Pump Tank Gallons: PT Date

Pump Make Model Serial No

Nitrification Field No Fields 1 Square Feet 1080 Linear Feet 360

No Lines 3 Trench Width 36" Max Trench Bottom Depth 36" Gravel Depth 12"

/ New System Repair System Type I (II) III IV V VI

System Description Conv. Gravity

Repair System Description pump to conv. lines

Maintenance Agreement Required Yes / No

/ House/Mod. Home No Bedrooms 3

/ Mobile Home No Bathrooms 2

Business No Employees

Other


Slab / Crawl Space Basement w/plumbing Basement wo/plumbing

Water Supply: Individual / Community / Public

Comments: 193'

Comments:

INITIAL SITE SKETCH

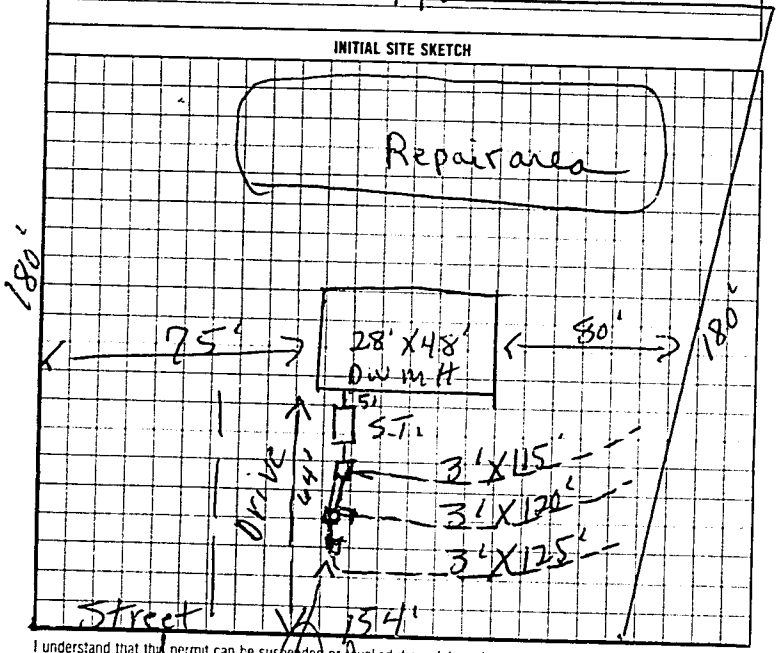

AS BUILT SKETCH

Same as initial Sketch

I understand that this permit can be suspended or revoked if any false information is supplied toward securing the permit/any unauthorized changes are made to the site/any unauthorized changes are made in the installation of the system

Signed [signature]

Improvement Permit by P.C. moore date 3-13-96

Existing System Inspection by P.C. moore date 3-13-96

Installed by G E M Enterprises

Certificate of Completion by date

Operation Permit by P.C. moore date 3-27-96

to count AUTH DEPT COPY WHITE INSPECTION COPY (FINAL) GREEN OWNER COPY (FINAL) YELLOW INSPECTION COPY (INITIAL) PINK OWNER COPY (INITIAL) GOLD

Authorization to coust Expires 60 mos from issue