IREDELL COUNTY HEALTH DEPARTMENT

STATESVILLE 704-878-5305 MOORESVILLE 704-664-5281

#63283

IMPROVEMENT PERMIT / CERTIFICATE OF COMPLETION / OPERATION PERMIT / EXISTING SYSTEM INSPECTION

PROPERTY DESCRIPTION NO. 24765 DATE 9-6-96 TAX MAP NO. 116-2-A-30 Watershed: ☐ Yes ☐ No

OWNER OR CONTRACTOR Susan G. Walker PHONE: Business Home 876-1488

ADDRESS 1283 Turnerburg Hwy Statesville

LOCATION Old Mocksville Rd TR coolsp. TR Coolwood Drive 3rd lot Rt.

SUBDIVISION Coolwood BLOCK / SECTION LOT 30 LOT AREA .195 acres SITE CLASS. PS DESIGN FLOW 360 L.T.A.R. .3

Septic Tank: 1000 Gallons; STB $21 Date 8-15-96

Pump Tank: Gallons; PT Date

Pump Make: Model Serial No.

Nitrification Field: No Fields 1 Square Feet 900 Linear Feet 300

No Lines 3 Trench Width 36" Max Trench Bottom Depth 36" Gravel Depth N/A

☑ New System ☐ Repair System Type: I, II, (III), IV, V, VI

System Description: Gravity chambers

Repair System Description: Pump To Panels

Maintenance Agreement Required: ☐ Yes ☑ No

☐ House/Mod. Home ☑ Mobile Home ☐ Business ☐ Other

No. Bedrooms 3 No. Bathrooms 2 No. Employees


☐ Slab ☑ Crawl Space ☐ Basement w/plumbing ☐ Basement wo/plumbing

Water Supply: ☐ Individual ☐ Community ☑ Public


Comments:

Comments:

INITIAL SITE SKETCH

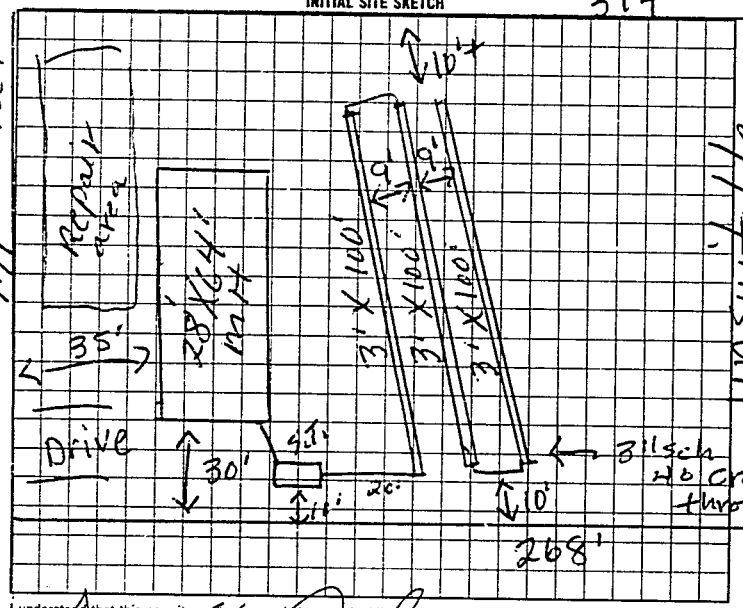

AS BUILT SKETCH

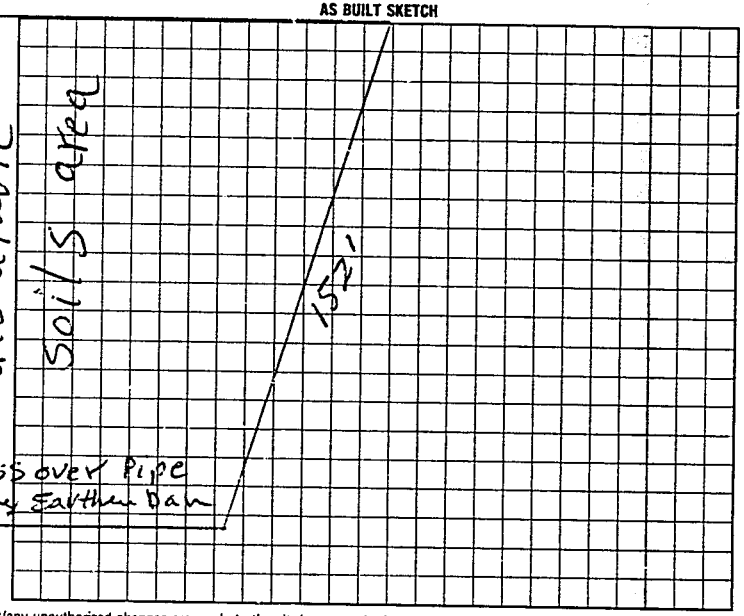

I understand that this permit can be suspended or revoked if any false information is supplied toward securing the permit/any unauthorized changes are made to the site/any unauthorized changes are made in the installation of the system.

Signed: Jerry F. Carter

Improvement Permit by: L.E. Moore date 9-6-96

Existing System Inspection by: L.C. Moore date 9-6-96

Installed by: G & M Enter.

Certificate of Completion by:

Operation Permit by: Man C.O.D. RS date 9-23-96

date

Authorization to Const. Expires 6 months from issue

to cover.

HEALTH DEPT. COPY: WHITE INSPECTION COPY (FINAL): GREEN OWNER COPY (FINAL): YELLOW INSPECTION COPY (INITIAL): PINK OWNER COPY (INITIAL): GOLD