IREDELL COUNTY HEALTH DEPARTMENT

STATESVILLE 704-878-5305 MOORESVILLE 704-664-5281

64052

IMPROVEMENT PERMIT / CERTIFICATE OF COMPLETION / OPERATION PERMIT / EXISTING SYSTEM INSPECTION

PROPERTY DESCRIPTION NO. 24351 DATE 7-27-96 TAX MAP NO 11L-1-A-31

OWNER OR CONTRACTOR Floyd Duckett PHONE: Business Watershed: ☐ Yes ☐ No

ADDRESS 138 Coolwood Dr. Home 871-2220

LOCATION 64E TL Coolsp Rt TL Coolwood Dr. 1/8 mi Rt

SUBDIVISION Coolwood BLOCK / SECTION LOT 31 LOT AREA .97 acres SITE CLASS. PS DESIGN FLOW 360 L.T.A.R. .3

Septic Tank: 1000 Gallons; STB 794 Date 8-20-96

Pump Tank: Gallons; PT Date

Pump Make: Model Serial No.

Nitrification Field: No Fields 1 Square Feet 1200 Linear Feet 400

No Lines 4 Trench Width 36" Max Trench Bottom Depth 36" Gravel Depth 12"

☒ New System ☐ Repair System Type: I, ☒ III, IV, V, VI

System Description: Conv. Gravity

Repair System Description: Pump to Chamber

Maintenance Agreement Required: ☐ Yes ☒ No

☐ House/Mod. Home No. Bedrooms 3

☐ Mobile Home No. Bathrooms 2

☐ Business No. Employees

☐ Other

☐ Slab ☐ Crawl Space ☐ Basement w/plumbing ☐ Basement wo/plumbing


Water Suppiy: ☐ Individual ☐ Community ☒ Public

Comments:


268'

Comments:

INITIAL SITE SKETCH

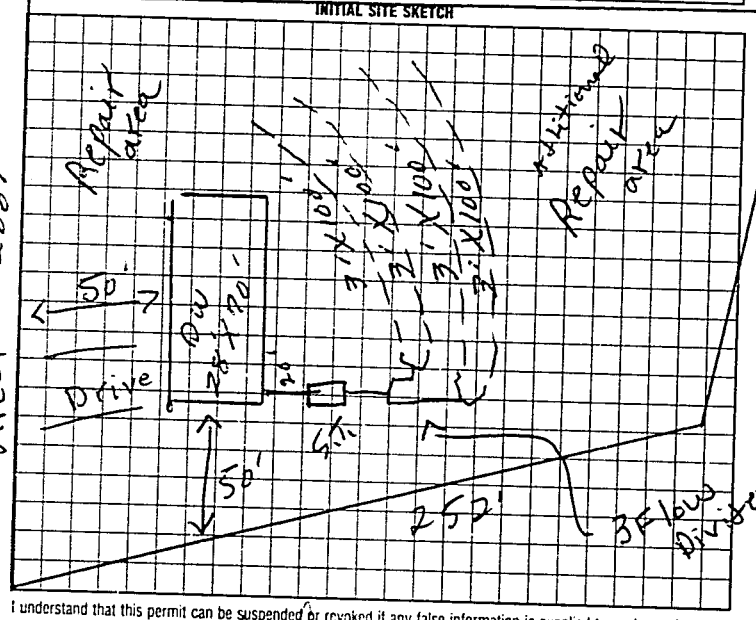

AS BUILT SKETCH

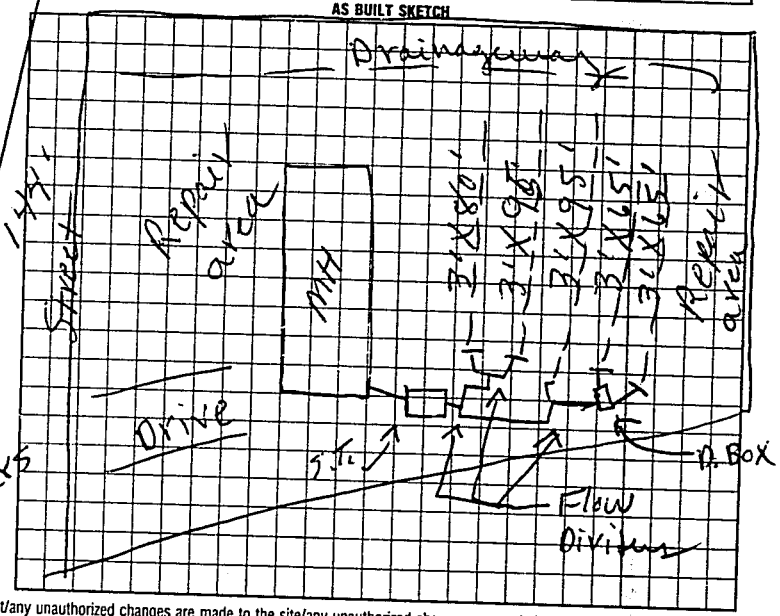

I understand that this permit can be suspended or revoked if any false information is supplied toward securing the permit/any unauthorized changes are made to the site/any unauthorized changes are made in the installation of the system.

Signed: Floyd Duckett

Improvement Permit by: P. C. Moore date 7-27-96

Existing System Inspection by: P. C. Moore date 7-27-96

Installed by: A-1 Backhoe

Certificate of Completion by: date

Operation Permit by: P. C. Moore date 10-24-96

HEALTH DEPT COPY: WHITE INSPECTION COPY (FINAL): GREEN OWNER COPY (FINAL): YELLOW INSPECTION COPY (INITIAL): PINK OWNER COPY (INITIAL): GOLD

To comm authorization To comm Expires 60 mos from issue