IREDELL COUNTY HEALTH DEPARTMENT

63379

STATESVILLE 704-878-5305 MOORESVILLE 704-664-5281

IMPROVEMENT PERMIT / CERTIFICATE OF COMPLETION / OPERATION PERMIT / EXISTING SYSTEM INSPECTION

PROPERTY DESCRIPTION NO. 247819 DATE 9-6-96 TAX MAP NO. 116-2-A-19 Watershed: ☐ Yes ☐ No

OWNER OR CONTRACTOR Piedmont Housing PHONE: Business 528-7128 Home

ADDRESS 1040 Charlotte Hwy Troutman N.C.

LOCATION off Mocks Rd TR Cool Sp. TR Coolwood 4th lot left

SUBDIVISION Coolwood BLOCK / SECTION LOT 19 LOT AREA 180'x180' SITE CLASS. PS DESIGN FLOW L.T.A.R.

Septic Tank: 1000 Gallons; STB 826 Date 7-28-96

Pump Tank: Gallons; PT Date

Pump Make: Model Serial No.

Nitrification Field: No Fields 1 Square Feet 1200 Linear Feet 400

No Lines 4 Trench Width 36" Max Trench Bottom Depth 36" Gravel Depth 12"

☑ New System ☐ Repair System Type: I, II, III, IV, V, VI

System Description: Conv. Gravity

Repair System Description: Pump to Conv.

Maintenance Agreement Required: ☐ Yes ☐ No

☐ House/Mod. Home No. Bedrooms 3

☑ Mobile Home No. Bathrooms 2

☐ Business No. Employees

☐ Other


☐ Slab ☑ Crawl Space ☐ Basement w/plumbing ☐ Basement wo/plumbing

Water Supply: ☐ Individual ☐ Community ☑ Public

Comments:

Comments:

INITIAL SITE SKETCH

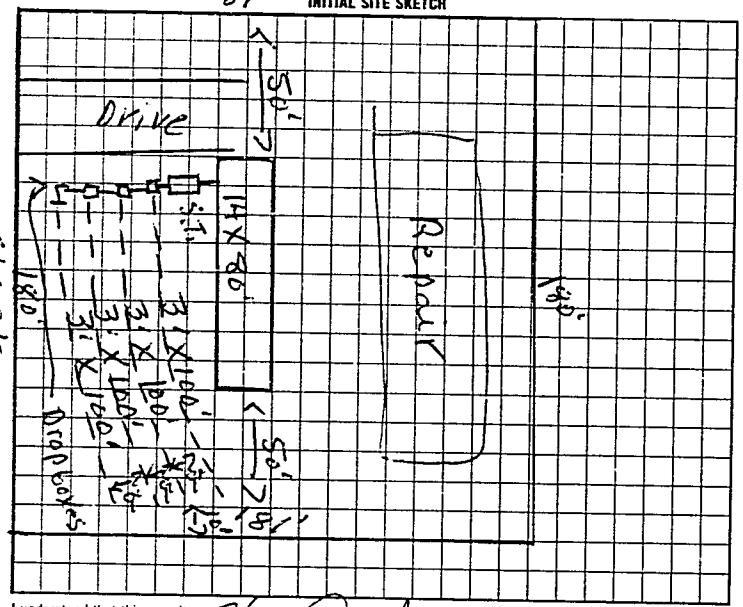

AS BUILT SKETCH

Same as initial Sketch

I understand that this permit can be suspended or revoked if any false information is supplied toward securing the permit/any unauthorized changes are made to the site/any unauthorized changes are made in the installation of the system.

Signed: Jerry A. Caitlin

Improvement Permit by: L.C. moore date 9-6-96

Authorization to Construct Existing System Inspection by: L.C. moore date 9-6-96

Installed by: G & M Enterprizes

Certificate of Completion by: date

Operation Permit by: L.C. moore date 9-10-96

HEALTH DEPT. COPY: WHITE INSPECTION COPY (FINAL): GREEN OWNER COPY (FINAL): YELLOW INSPECTION COPY (INITIAL): PINK OWNER COPY (INITIAL): GOLD

to Const.

Authorization to Const Expires 60 mos from issue

9 1 8 1 0 0