~~4:00~~ 4:00 47/PT

IREDELL COUNTY HEALTH DEPARTMENT

STATESVILLE 704-878-5305 MOORESVILLE 704-664-5281

IMPROVEMENT PERMIT / CERTIFICATE OF COMPLETION / OPERATION PERMIT / EXISTING SYSTEM INSPECTION

PROPERTY DESCRIPTION NO. 21924 DATE 9-28-95 TAX MAP NO. 116-A-Pt of 47 Watershed: ☐ Yes ☑ No

OWNER OR CONTRACTOR Clark Abel PHONE: Business Home 871-1927

ADDRESS 133 Barry Oak Rd Statesville

LOCATION 64E TL Cool Spring Rd TL Coolwood Dr. 3rd lot left

SUBDIVISION Coolwood BLOCK / SECTION LOT 18 LOT AREA .174acres SITE CLASS. PS DESIGN FLOW 360 L.T.A.R. .3

Septic Tank: 1000 Gallons; STB 794 Date 8-7-95

Pump Tank: Gallons; PT Date

Pump Make: Model Serial No.

Nitrification Field: No Fields 1 Square Feet 1200 Linear Feet 400

No Lines 3 Trench Width 36" Max Trench Bottom Depth 36" Gravel Depth 12"

☑ New System ☐ Repair System Type: I, II, III, IV, V, VI

System Description: conv. Gravity

Repair System Description:

Maintenance Agreement Required: ☐ Yes ☑ No

☐ House/Mod. Home ☑ Mobile Home ☐ Business ☐ Other


No. Bedrooms 3 No. Bathrooms 2 No. Employees

☐ Slab ☐ Crawl Space ☐ Basement w/plumbing ☐ Basement wo/plumbing

Water Supply: ☐ Individual ☐ Community ☑ Public

Comments: 176'

INITIAL SITE SKETCH

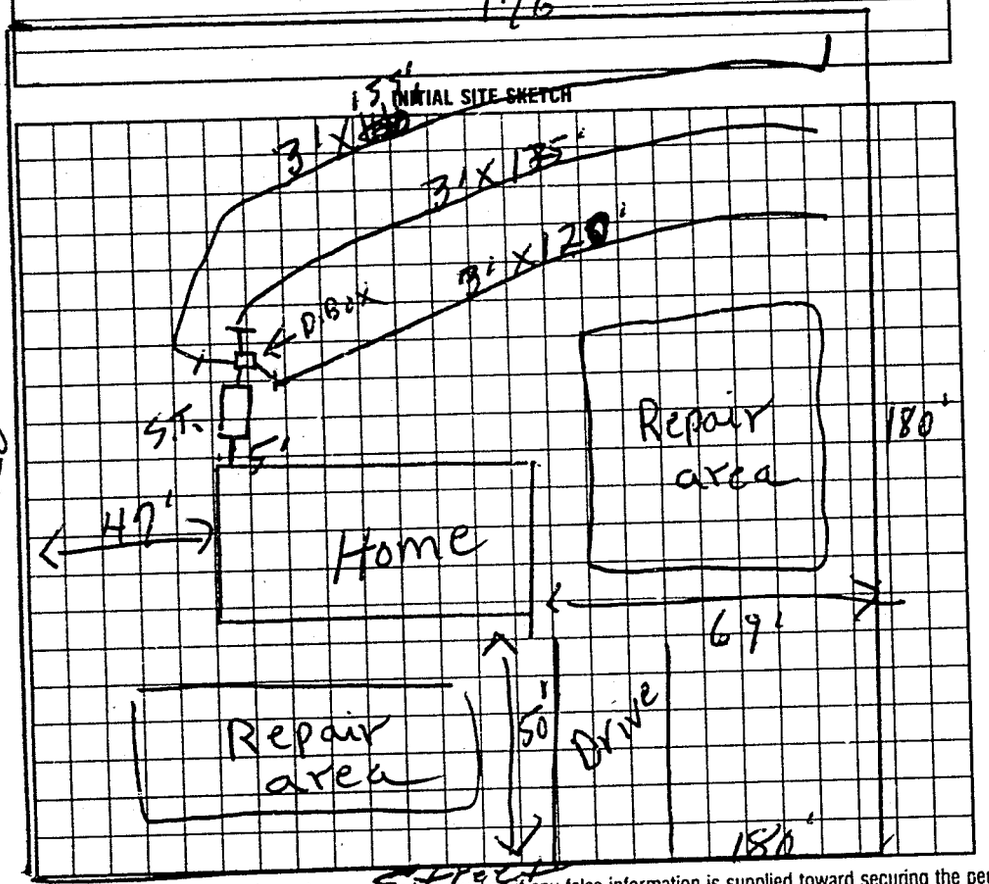

Comments:

AS BUILT SKETCH

Same as initial sketch

I understand that this permit can be suspended or revoked if any false information is supplied toward securing the permit/any unauthorized changes are made to the site/any unauthorized changes are made in the installation of the system.

Signed: X E. W. Holle

Improvement Permit by: D.C. moore date 9-28-95

Existing System Inspection by date

Installed by: A-1 Backhoe date

Certificate of Completion by: date

Operation Permit by: D.C. moore date 10-18-95

HEALTH DEPT COPY WHITE INSPECTION COPY (FINAL) GREEN OWNER COPY (FINAL) YELLOW INSPECTION COPY (INITIAL) PINK OWNER COPY (INITIAL): GOLD

8 7 8 7 0 0