58803

IREDELL COUNTY HEALTH DEPARTMENT

STATESVILLE 704-878-5305 MOORESVILLE 704-664-5281

IMPROVEMENT PERMIT / CERTIFICATE OF COMPLETION / OPERATION PERMIT / EXISTING SYSTEM INSPECTION

PROPERTY DESCRIPTION NO. 22830 DATE 12-20-95 TAX MAP NO. 11L-2-A-20 Watershed: ☑ Yes ☐ No

OWNER OR CONTRACTOR Larry Waddell PHONE: Business Home 871 8469

ADDRESS 108 Flintlock Lane Statesville (143 coolwood Dr.)

LOCATION 64E TL Swann TR Riverhill TR coolsp TR Coolwood Drive 1000' Left

SUBDIVISION Coolwood BLOCK / SECTION LOT 20 LOT AREA 180'X182' SITE CLASS. 1 DESIGN FLOW L.T.A.R.

Septic Tank: 1000 Gallons; STB 794 Date 12-14-95

Pump Tank: Gallons; PT Date

Pump Make: Model Serial No.

Nitrification Field: No Fields 1 Square Feet 1200 Linear Feet 400

No Lines 3 Trench Width 36" Max Trench Bottom Depth 36" Gravel Depth 12"

☑ New System ☐ Repair System Type: I, II, III, IV, V, VI

System Description: Conv. Gravity

Repair System Description: Pump to chambers

Maintenance Agreement Required: ☐ Yes ☑ No

☐ House/Mod. Home ☑ Mobile Home ☐ Business ☐ Other


No. Bedrooms 3 No. Bathrooms 2 No. Employees

☐ Slab ☑ Crawl Space ☐ Basement w/plumbing ☐ Basement wo/plumbing

Water Supply: ☐ Individual ☐ Community ☑ Public

Comments:

INITIAL SITE SKETCH

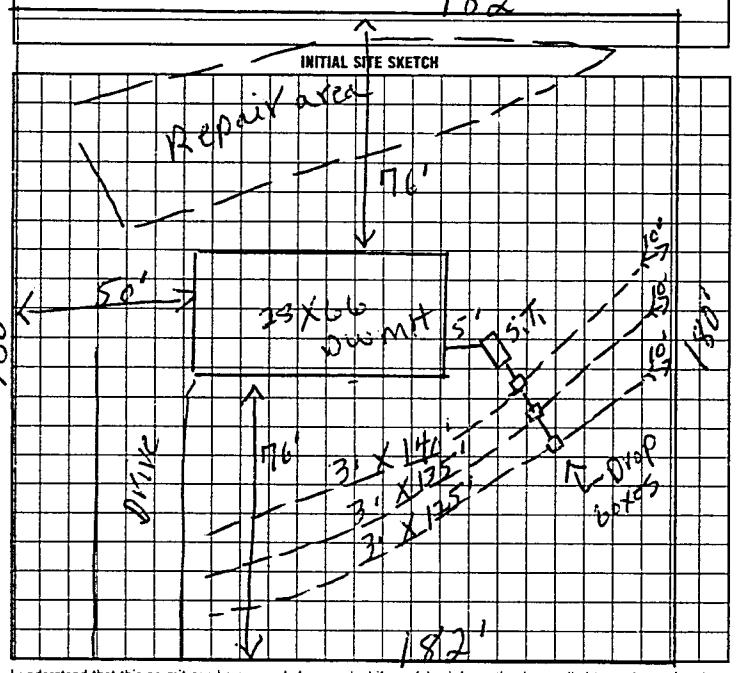

Comments:

Mobile Home was not located at Time of This inspection

AS BUILT SKETCH

Same as initial Sketch

I understand that this permit can be suspended or revoked if any false information is supplied toward securing the permit/any unauthorized changes are made to the site/any unauthorized changes are made in the installation of the system.

Signed: X Larry Waddell Jr Installed by: A-1 Backhoe.

Improvement Permit by: T. C. Moore date 12-20-95 Certificate of Completion by: date

Existing System Inspection by: T. C. Moore date 12-20-95 Operation Permit by: C Bradley Keen date 2/29/96

Authorization to construct

COPY WHITE INSPECTION COPY (FINAL) GREEN OWNER COPY (FINAL) YELLOW INSPECTION COPY (INITIAL) PINK OWNER COPY (INITIAL) GOLD

Authorization to consit Expires 60 mos from issue date

8 8 9 2 0 0