IREDELL COUNTY HEALTH DEPARTMENT

STATESVILLE 704-878-5305 MOORESVILLE 704-664-5281

IMPROVEMENT PERMIT / CERTIFICATE OF COMPLETION / OPERATION PERMIT / EXISTING SYSTEM INSPECTION

PROPERTY DESCRIPTION NO. 25656 DATE 12-10-96 TAX MAP NO. 11L-2-YA-17 Watershed: ☐ Yes ☒ No

OWNER OR CONTRACTOR John Gaither PHONE: Business 873-1014 Home

ADDRESS 590 Mocksville Hwy Statesville

LOCATION bYE TL River~~road~~ Hill RC TR Cool Springs Rd TR Coolwood lot on left

SUBDIVISION Coolwood BLOCK / SECTION LOT 17 LOT AREA SITE CLASS. P/S DESIGN FLOW 360 L.T.A.R. 0.

Septic Tank: 1000 Gallons; STB 620 Date 12-97

Pump Tank: Gallons; PT Date

Pump Make: Model Serial No.

Nitrification Field: No Fields 1 Square Feet Linear Feet

No Lines 4 Trench Width 36in Max Trench Bottom Depth 36in Gravel Depth 12in

☒ New System ☐ Repair System Type: I, (II) III, IV, V, VI

System Description: Orig. Conventional

Repair System Description: Pump Chamber

Maintenance Agreement Required: ☐ Yes ☒ No

☐ House/Mod. Home ☒ Mobile Home ☐ Business ☐ Other

No. Bedrooms 3 No. Bathrooms 2 No. Employees


☐ Slab ☒ Crawl Space ☐ Basement w/plumbing ☐ Basement wo/plumbing

Water Supply: ☐ Individual ☐ Community ☒ Public


Comments: Keep lines on contour, 9ft on center

Comments: House site Pushed over 30ft

165' INITIAL SITE SKETCH

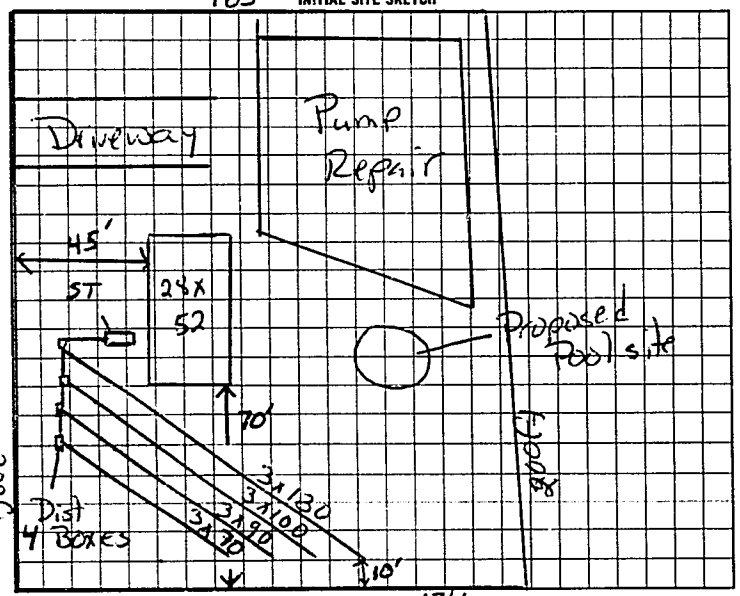

AS BUILT SKETCH

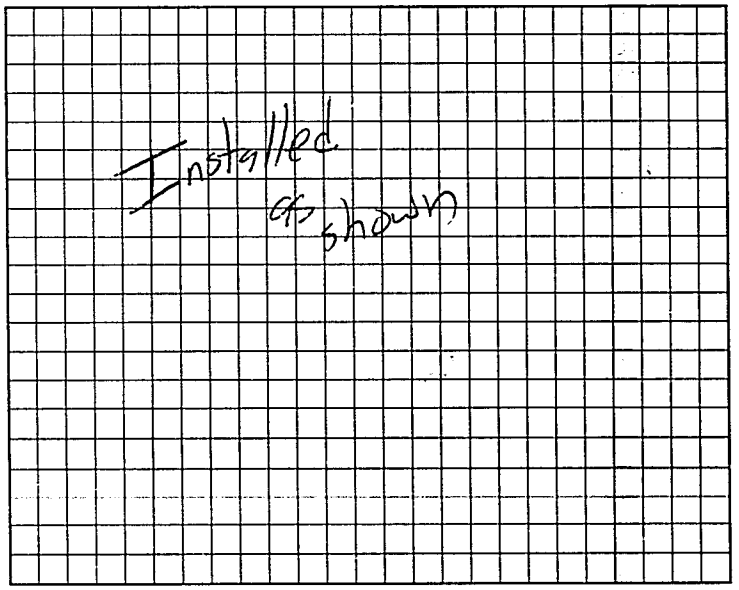

I understand that this permit can be suspended or revoked if any false information is supplied toward securing the permit/any unauthorized changes are made to the site/any unauthorized changes are made in the installation of the system. Improvement Permit is valid for 60 months from date of issuance. Authorization to Const. expires 5yrs from issue date

Signed: John R. Gaither

Improvement Permit by: Mark C. Ostby date 12-12-96

~~Existing System Inspection by:~~ Authorization to const Mark C. Ostby date 12-12-96

Installed by: Sammy Reavis

Certificate of Completion by: date

Operation Permit by: Mark C. Ostby date 3-11-97

HEALTH DEPT. COPY: WHITE INSPECTION COPY (FINAL): GREEN OWNER COPY (FINAL): YELLOW INSPECTION COPY (INITIAL): PINK OWNER COPY (INITIAL): GOLD

0 0 0 2 3 2