IREDELL COUNTY HEALTH DEPARTMENT

STATESVILLE 704-878-5305 MOORESVILLE 704-664-5281

IMPROVEMENT PERMIT / CERTIFICATE OF COMPLETION / OPERATION PERMIT / EXISTING SYSTEM INSPECTION

PROPERTY DESCRIPTION NO. 67103 DATE 6-13-97 TAX MAP NO. 4777 888264

OWNER OR CONTRACTOR Tracey G. Combs PHONE: Business ____ Watershed: ☐ Yes ☐ No

ADDRESS 398 Deer Chase Circle Home 704 881 0871

LOCATION Old mocksville TR white oak branch Rd TL Deerchase TR Deerchase cir. 3rd lot l/s

SUBDIVISION Deerchase BLOCK / SECTION ____ LOT 85 LOT AREA 2.16 acres SITE CLASS. PS DESIGN FLOW 360 L.T.A.R. .3

Septic Tank: 1000 Gallons; STB ____ Date ____

Pump Tank: ____ Gallons; PT ____ Date ____

Pump Make: ____ Model ____ Serial No. ____

Nitrification Field: No Fields 1 Square Feet 1200 Linear Feet 400

No Lines 4 Trench Width 36" Max Trench Bottom Depth 36" Gravel Depth 12"

☒ New System ☐ Repair System Type: I, II, III, IV, V, VI

System Description: Conv. Gravity

Repair System Description: " "

Maintenance Agreement Required: ☐ Yes ☒ No

☐ Slab ☒ Crawl Space ☐ Basement w/plumbing ☐ Basement wo/plumbing

☐ House/Mod. Home ☐ Mobile Home ☐ Business ☐ Other


No. Bedrooms 3 No. Bathrooms 2 No. Employees ____

Water Supply: ☒ Individual ☐ Community ☐ Public — well next door


Comments:

Comments:

INITIAL SITE SKETCH

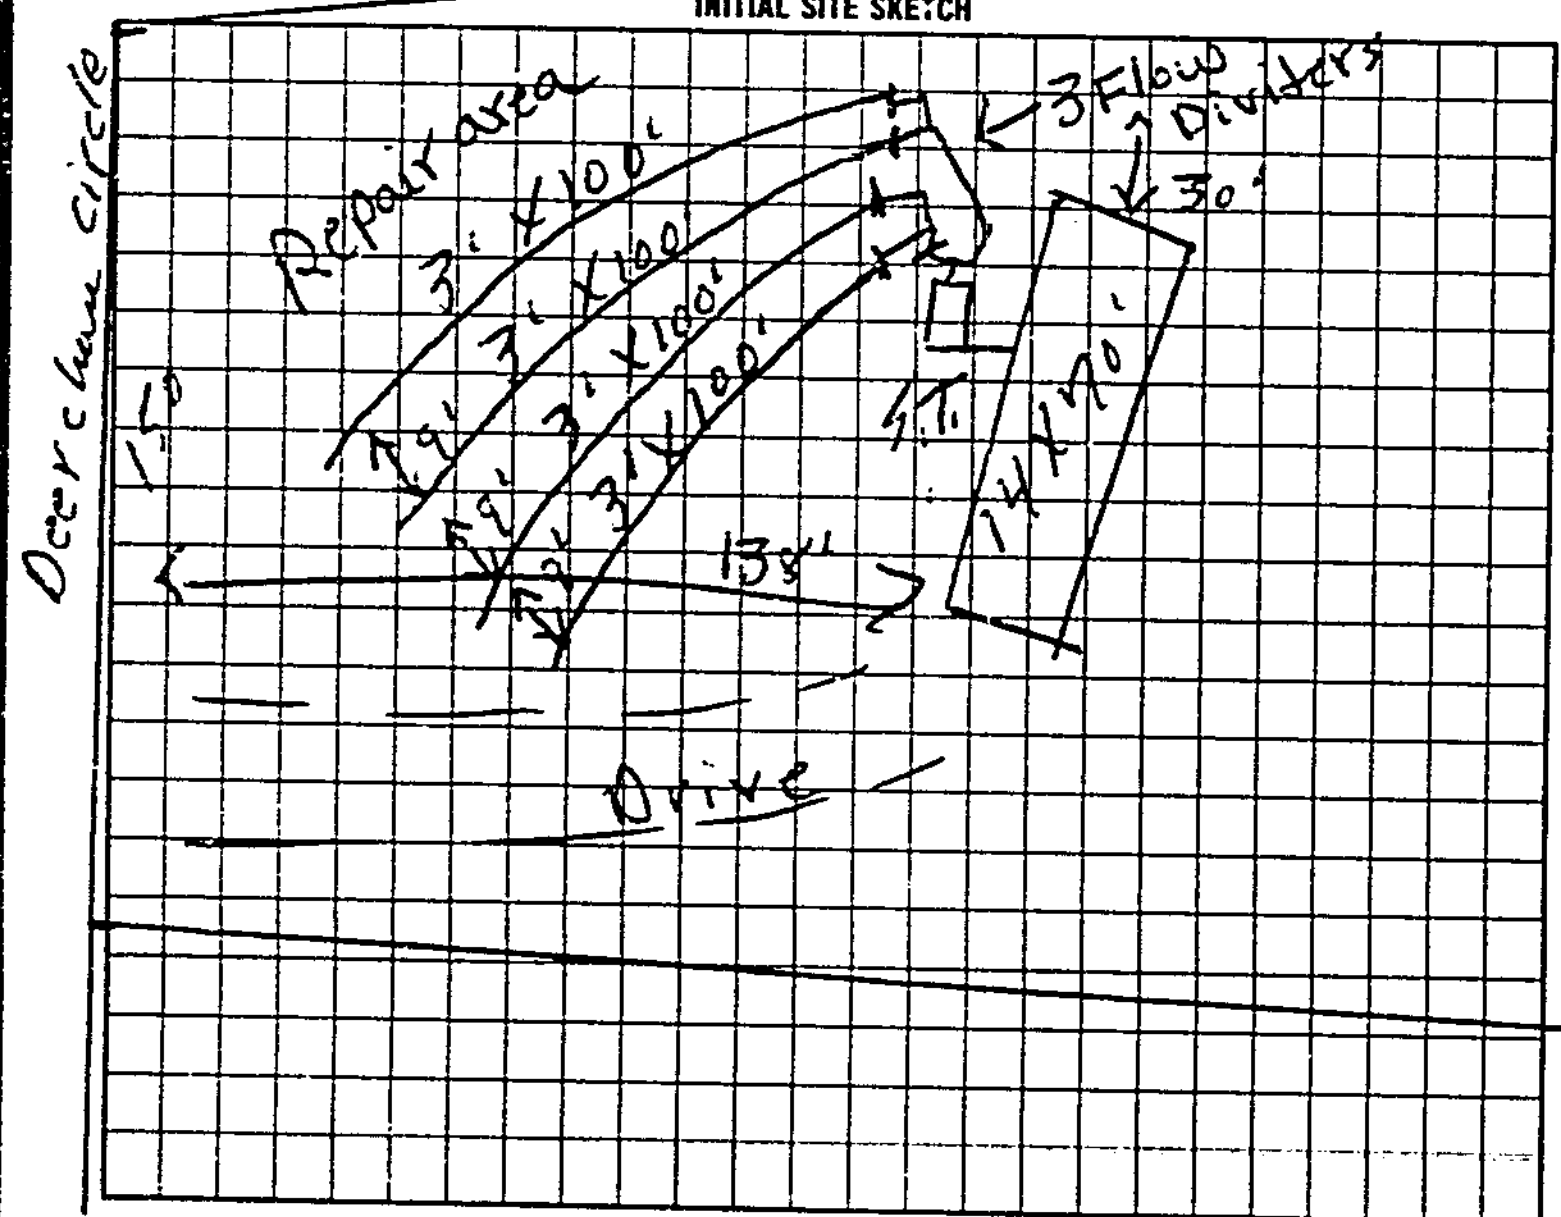

AS BUILT SKETCH

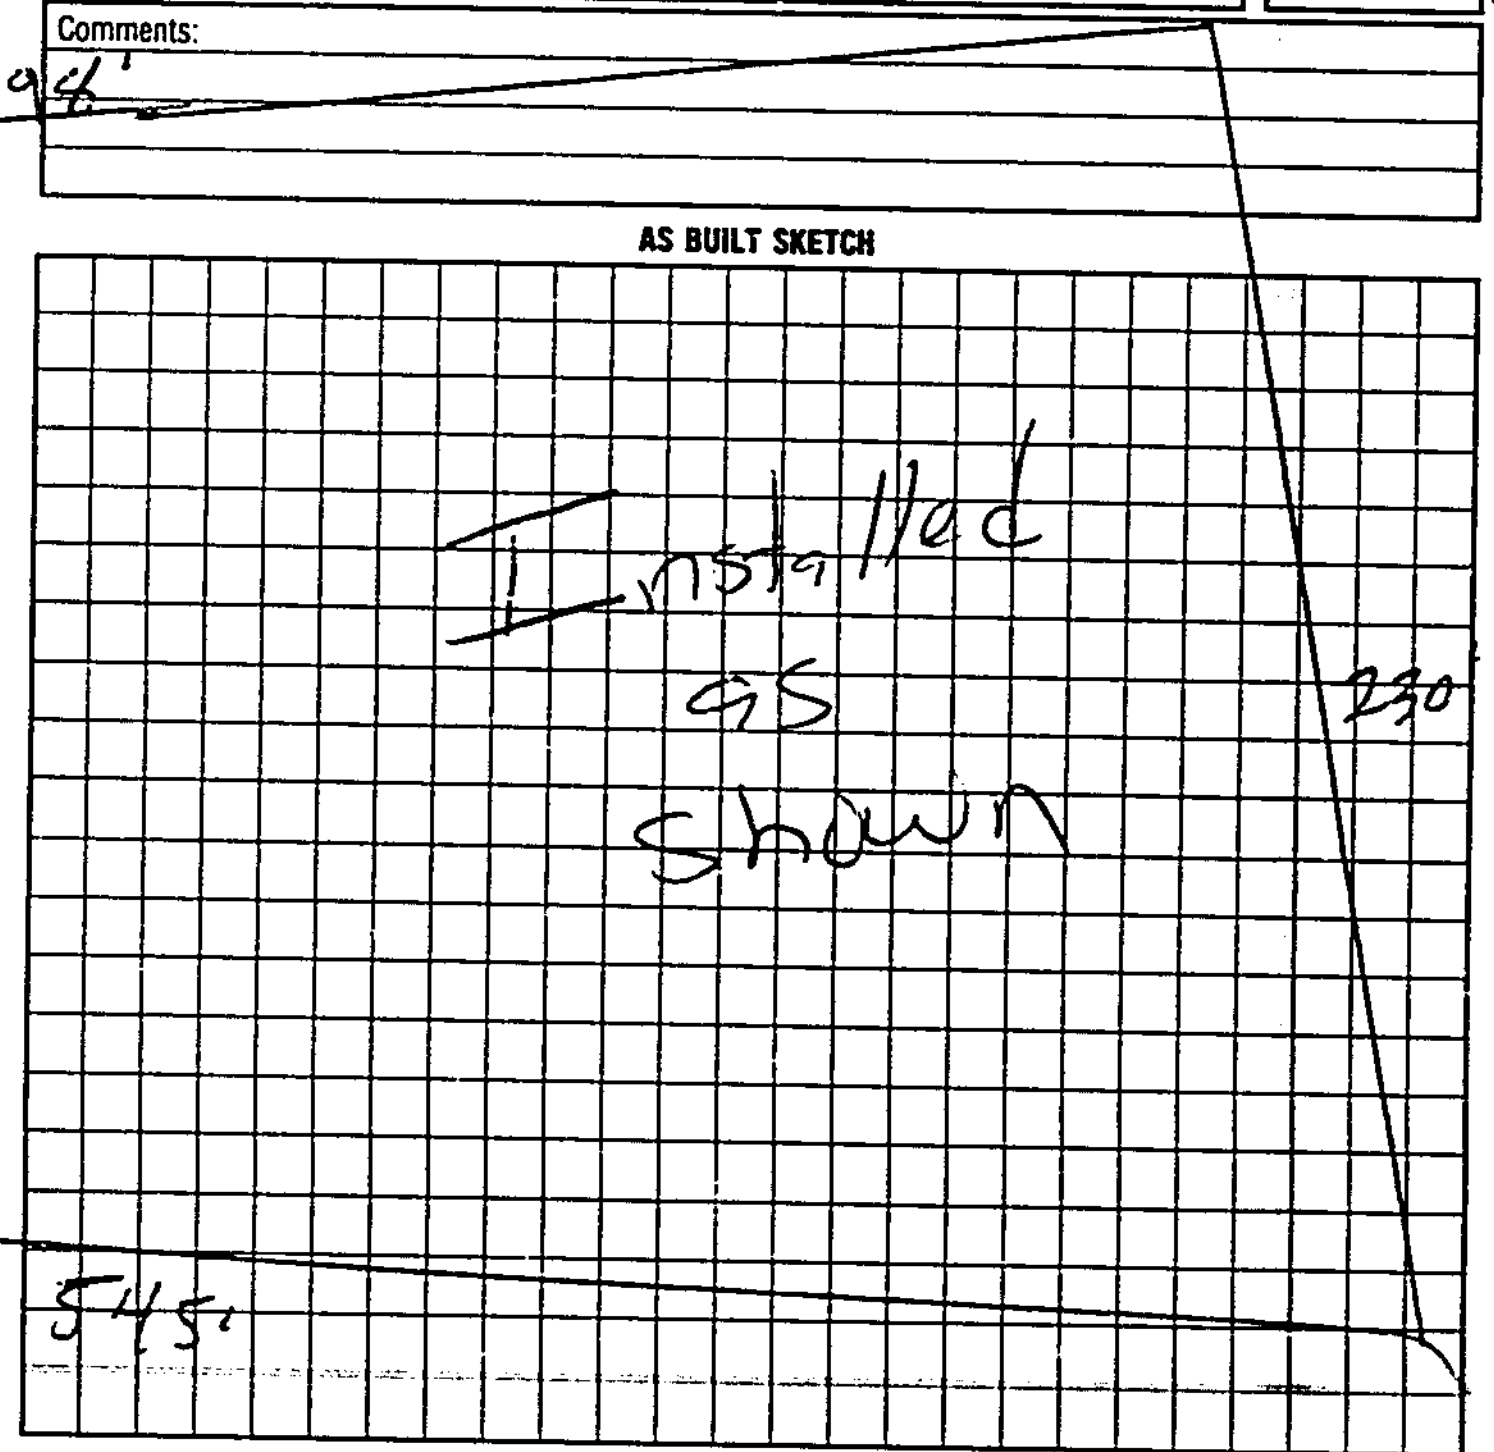

I understand that this permit can be suspended or revoked if any false information is supplied toward securing the permit/any unauthorized changes are made to the site/any unauthorized changes are made in the installation of the system. Improvement Permit is valid for 60 months from date of issuance.

Signed: x Tracey Combs

Improvement Permit by: L. C. Moore date 6-13-97

Existing System Inspection by: Authorization to court. L. C. Moore date 6-13-97

Installed by: James Huddler

Certificate of Completion by: ____ date ____

Operation Permit by: [signature] RS date 6-26-97

HEALTH DEPT. COPY: WHITE INSPECTION COPY (FINAL): GREEN OWNER COPY (FINAL): YELLOW INSPECTION COPY (INITIAL): PINK OWNER COPY (INITIAL): GOLD

Authorization to court Expires 60 mos from issue

220000