IREDELL COUNTY HEALTH DEPARTMENT

STATESVILLE 704-878-5305 MOORESVILLE 704-664-5281

IMPROVEMENT PERMIT / CERTIFICATE OF COMPLETION / OPERATION PERMIT / EXISTING SYSTEM INSPECTION

PROPERTY DESCRIPTION NO. 1626 DATE 7-8-93

OWNER OR CONTRACTOR Leroy Lockhart PHONE: Business TAX MAP NO. 116-1-A-72

ADDRESS Detroit MI. Home

LOCATION Old Mocksville Rd TR White Oak Branch TR To Dog Trail 1/2 mi on Rt

SUBDIVISION Deer Park BLOCK / SECTION LOT 72 LOT AREA 1.9 acres SITE CLASS P.S. L.T.A.R. .35

Water Supply: ☑ Individual ☐ Community ☐ Public

Septic Tank: 1000 Gallons; STB 1012 Date 5-21-93

Pump Tank: Gallons; PT Date

Nitrification Field: No. Fields 1 Square Feet 1035 Linear Feet 345

No. Lines 3 Trench Width 36 Trench Depth 24 Gravel Depth 12

☑ New System ☐ Repair System Type: I. II. IV. V. VI

System Description: Conv. Gravity

Repair System Description: " "

Maintenance Agreement Required: ☐ Yes ☑ No

☐ House/Mod. Home ☑ Mobile Home ☐ Business ☐ Other

No. Bedrooms 2 No. Bathrooms 1 No. Employees

☐ Slab ☑ Crawl Space ☐ Basement w/plumbing ☐ Basement wo/plumbing

Garbage Disposal: ☐ Yes ☑ No


Auto. Dishwasher: ☐ Yes ☑ No

Auto. Washing Machine: ☐ Yes ☐ No


Other

Comments Well & mobile Home not located at time of this inspection Keep proper Distances from S.T. system

INITIAL SITE SKETCH

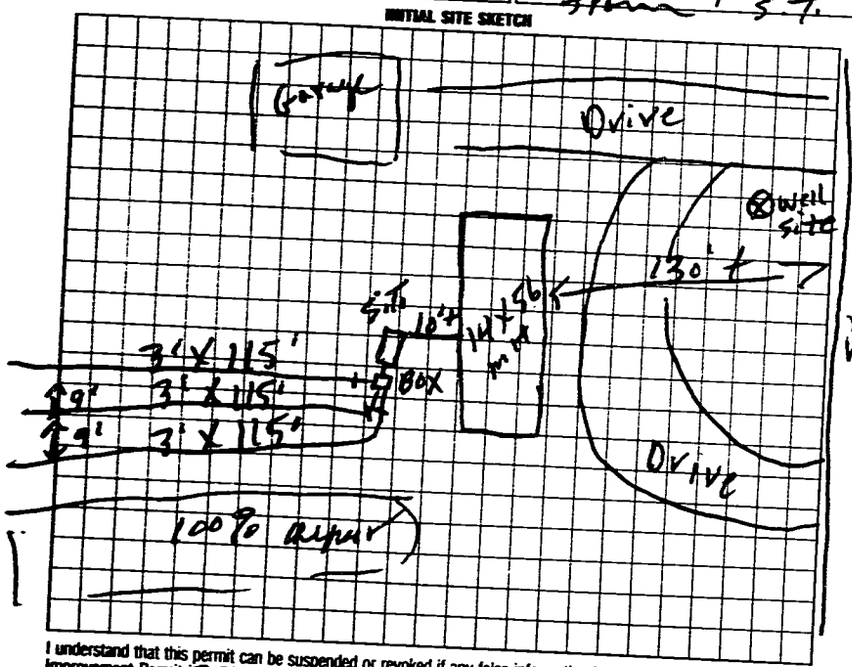

AS BUILT SKETCH

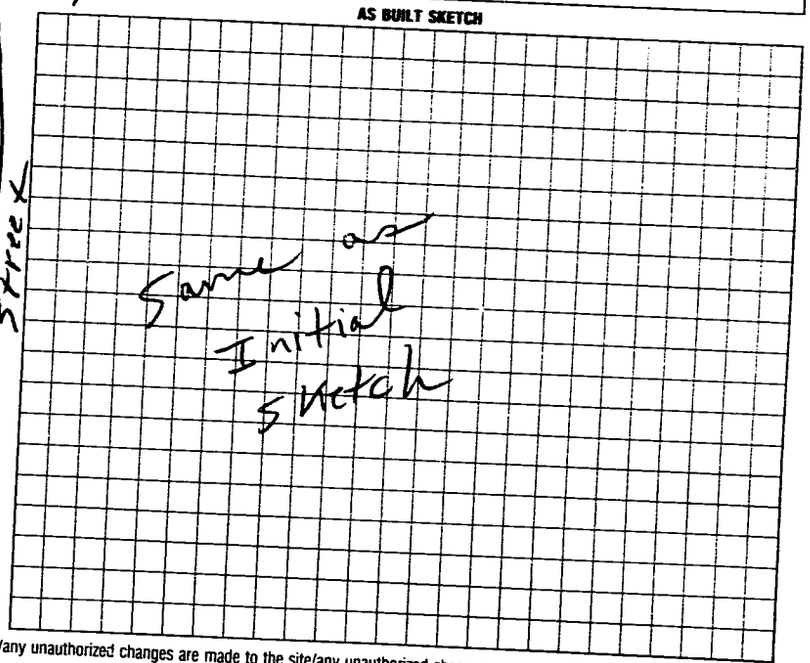

I understand that this permit can be suspended or revoked if any false information is supplied toward securing the permit/any unauthorized changes are made to the site/any unauthorized changes are made in the installation of the system. Improvement Permit is valid for 60 months from date of issuance.

Signed: Leroy Lockhart

Improvement Permit by: J. C. Moore date 7-8-93

Existing System Inspection by: date

Installed by: Tommy Frye

Certificate of Completion by: J. C. Moore date 7-30-93

Operation Permit by: date

HEALTH DEPT. COPY: WHITE INSPECTION COPY (FINAL): GREEN OWNER COPY (FINAL): YELLOW INSPECTION COPY (INITIAL): PINK OWNER COPY (INITIAL): GOLD