IREDELL COUNTY HEALTH DEPARTMENT

STATESVILLE 704-878-5305 MOORESVILLE 704-664-5281 56561

IMPROVEMENT PERMIT / CERTIFICATE OF COMPLETION / OPERATION PERMIT / EXISTING SYSTEM INSPECTION

PROPERTY DESCRIPTION NO. 19857 DATE 12-13-94 TAX MAP NO. 116-1-A-50 Watershed: ☐ Yes ☑ No

OWNER OR CONTRACTOR Wayne Cape PHONE: Business _____ Home 872-0669

ADDRESS 1517 Hoetts Rd Statesville

LOCATION 64 E TL on Mocksville Rd TR White Oak Branch Rd TL Deerchase 1/2 mi left

SUBDIVISION Deer Park BLOCK / SECTION _____ LOT 50 LOT AREA 1.17 acres SITE CLASS. PS DESIGN FLOW 360 L.T.A.R. .35

Septic Tank: 1000 Gallons; STB 760 Date 4-10-95

Pump Tank: _____ Gallons; PT _____ Date _____

Pump Make: _____ Model _____ Serial No. _____

Nitrification Field: No Fields 1 Square Feet 1050 Linear Feet 350

No Lines 5 Trench Width 36" Max Trench Bottom Depth 36" Gravel Depth 12"

☑ New System ☐ Repair System Type: I, ☑ III, IV, V, VI

System Description: Conv. Gravity

Repair System Description: Pump to Conv. Lines

Maintenance Agreement Required: ☐ Yes ☐ No

☐ House/Mod. Home No. Bedrooms 3

☐ Mobile Home No. Bathrooms 2

☑ Business No. Employees _____

☐ Other _____


☐ Slab ☐ Crawl Space ☑ Basement w/plumbing ☐ Basement wo/plumbing

Water Supply: ☑ Individual ☐ Community ☐ Public

Comments:

Comments:

INITIAL SITE SKETCH

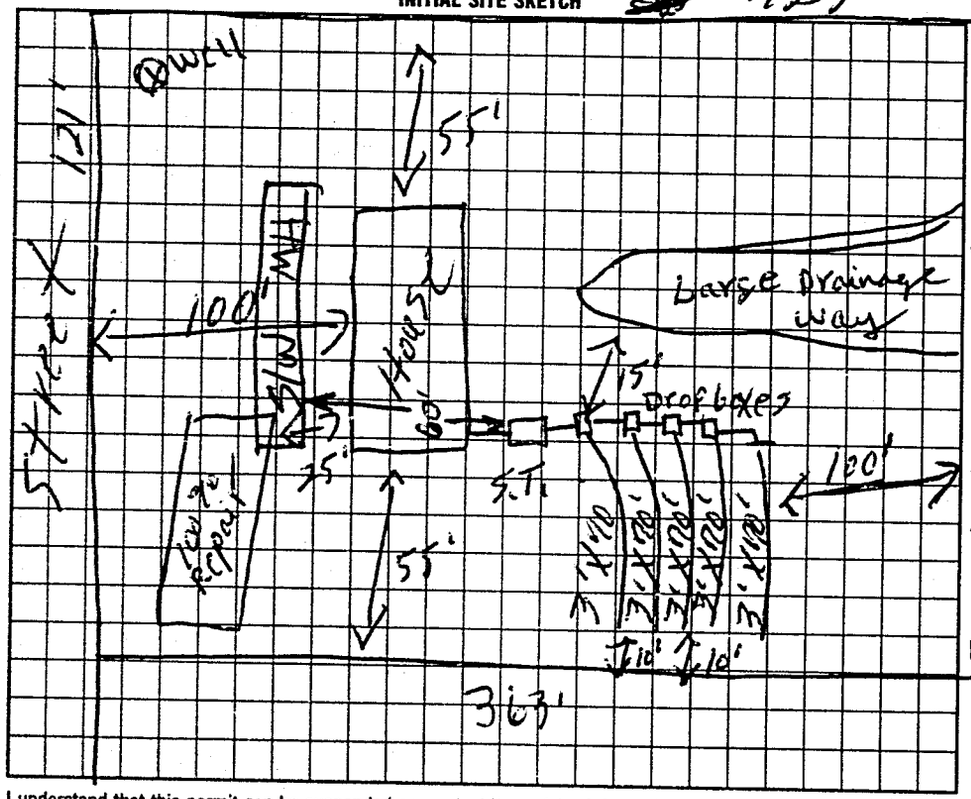

AS BUILT SKETCH

SYSTEM INSTALLED ACCORDING TO INITIAL SITE SKETCH

I understand that this permit can be suspended or revoked if any false information is supplied toward securing the permit/any unauthorized changes are made to the site/any unauthorized changes are made in the installation of the system. Improvement Permit is valid for 60 months from date of issuance.

Signed: X Wayne Cape

Improvement Permit by: P. C. Moore date 12-13-94

Existing System Inspection by: _____ date _____

Installed by: CARRY POWELL

Certificate of Completion by: Jack HEDRICK date 7-6-95

Operation Permit by: _____ date _____

HEALTH DEPT. COPY: WHITE INSPECTION COPY (FINAL): GREEN OWNER COPY (FINAL): YELLOW INSPECTION COPY (INITIAL): PINK OWNER COPY (INITIAL): GOLD