IREDELL COUNTY HEALTH DEPARTMENT

STATESVILLE 704-878-5305 MOORESVILLE 704-664-5281

IMPROVEMENT PERMIT / CERTIFICATE OF COMPLETION / OPERATION PERMIT / EXISTING SYSTEM INSPECTION

PROPERTY DESCRIPTION NO. 19203 DATE 9-30-94 TAX MAP NO. 116-1-A-46 Watershed: ☐ Yes ☐ No

OWNER OR CONTRACTOR Eddie Alspaugh PHONE: Business Home No Phone

ADDRESS Rt 2 Box 311 Cleveland, N.C. 27103

LOCATION 64 E TL old Mocksville TR white oak branch TL Deerchase 1mi on left

SUBDIVISION Deer Park BLOCK / SECTION LOT 46 LOT AREA acreage SITE CLASS. PS DESIGN FLOW 360 L.T.A.R. .35

Septic Tank: 1000 Gallons; STB 1012 Date 8-19-94

Pump Tank: Gallons; PT Date

Pump Make: Model Serial No.

Nitrification Field: No Fields 1 Square Feet 1045 Linear Feet 345

No Lines 3 Trench Width 36" Max Trench Bottom Depth 24" Gravel Depth 12"

☑ New System ☐ Repair System Type: I, II, III, IV, V, VI

System Description: Conv. Gravity

Repair System Description: " "

Maintenance Agreement Required: ☐ Yes ☐ No

☑ House/Mod. Home No. Bedrooms 3

☑ Mobile Home No. Bathrooms 2

☐ Business No. Employees

☐ Other


☐ Slab ☐ Crawl Space ☐ Basement w/plumbing ☐ Basement wo/plumbing

Water Supply: ☑ Individual ☐ Community ☐ Public

Comments:

Comments: well & mobile Home not located at time of this inspection Place them at proper distances from S.T. System as shown on Sketch

INITIAL SITE SKETCH

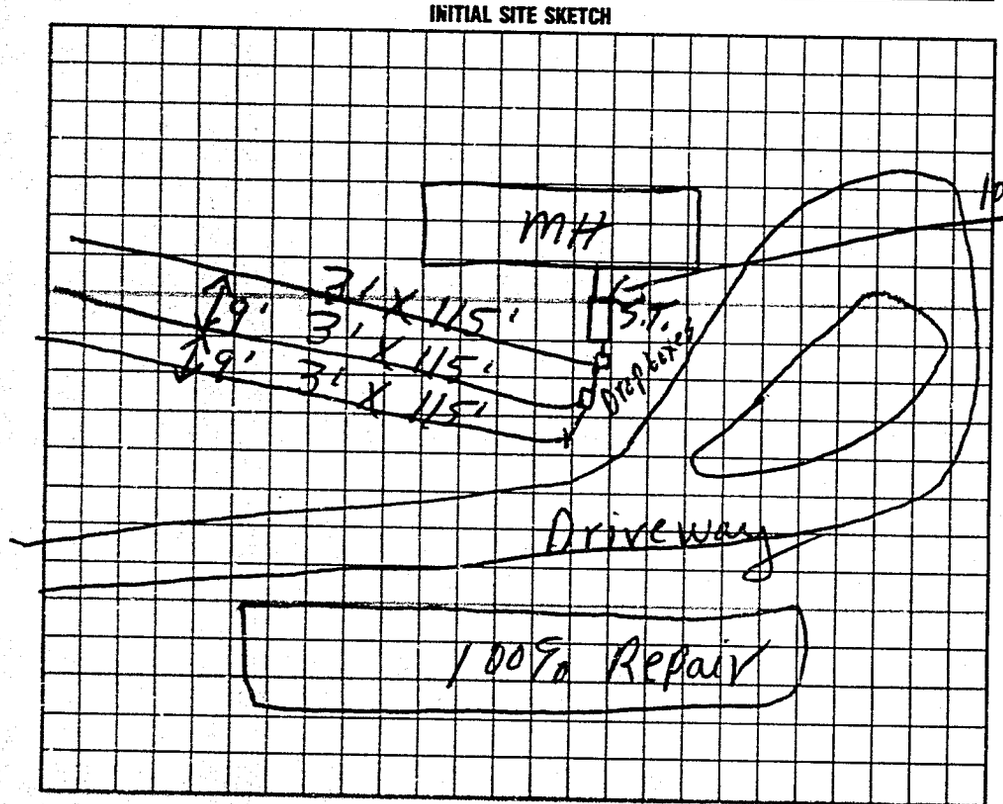

AS BUILT SKETCH

Same as initial sketch

I understand that this permit can be suspended or revoked if any false information is supplied toward securing the permit/any unauthorized changes are made to the site/any unauthorized changes are made in the installation of the system. Improvement Permit is valid for 60 months from date of issuance.

Signed: x Eddie Alspaugh

Improvement Permit by: L. C. Moore date 9-30-94

Existing System Inspection by: date

Installed by: Donald Lackey

Certificate of Completion by: L. C. Moore date 10-27-94

Operation Permit by: date

HEALTH DEPT. COPY: WHITE INSPECTION COPY (FINAL): GREEN OWNER COPY (FINAL): YELLOW INSPECTION COPY (INITIAL): PINK OWNER COPY (INITIAL): GOLD