IREDELL COUNTY HEALTH DEPARTMENT

STATESVILLE 704-878-5305 MOORESVILLE 704-664-5281 (C1)

IMPROVEMENT PERMIT / AUTHORIZATION TO CONSTRUCT / OPERATION PERMIT / EXISTING SYSTEM INSPECTION

PERMIT# 106107 PIN# 4778-06-7966 DATE 5-14-02

OWNER OR CONTRACTOR TONYA JUSTICE PHONE Business 704-252-0752 Home 704-596-5195

ADDRESS 104 SCOTTSHIRE DR, HIDDENITE, NC 28636

LOCATION US 21 NORTH, TR CHIEF THOMAS RD, TR HARMONY BLEND, LOT ON LEFT NEAR END

SUBDIVISION EASTERN ACRES BLOCK / SECTION ____ LOT 24 LOT AREA 1.26 ACRES SITE CLASS PS DESIGN FLOW 360 L.T.A.R. 0.30 GPD/FT²

Septic Tank: 1000 Gallons; STB 1012 Date 6-22-99
Pump Tank: ____ Gallons; PT ____ Date ____
Pump Make: ____ Model ____ Serial No ____
Nitrification Field: No Fields 1 Square Feet 1200 Linear Feet 400
No Lines FOUR Trench Width 36" Max Trench Bottom Depth 36" Gravel Depth 12"

☐ New System ☐ Repair System Type: I (II) III IV V VI
System Description: CONVENTIONAL GRAVITY
Repair System Description: CONV. GRAVITY
Maintenance Agreement Required: ☐ Yes ☑ No
☐ Slab ☑ Crawl Space ☐ Basement w/plumbing ☐ Basement wo/plumbing


☐ House/Mod Home No. Bedrooms 3
☑ Mobile Home No. Bathrooms 2
☐ Business No. Employees ____
☐ Other ____

Water Supply:
☑ Individual
☐ Public
☐ Community
WELL


Comments/Conditions:

Comments/Conditions:

INITIAL SITE SKETCH

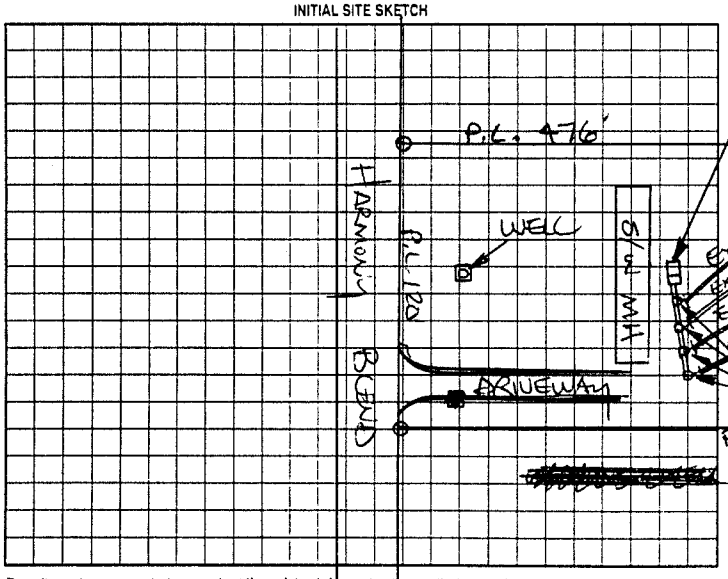

AS BUILT SKETCH

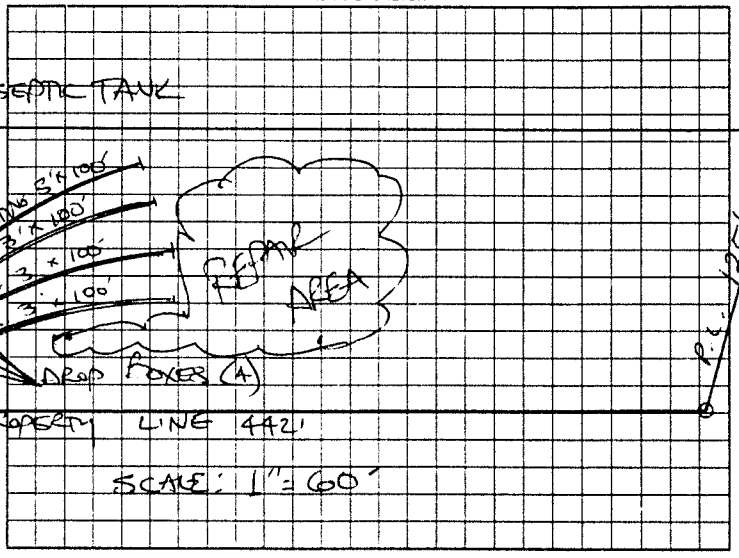

Permit can be suspended or revoked if any false information is supplied toward securing the permit/any unauthorized changes are made to the site any unauthorized changes are made in the installation of the system. Improvement Permit with plat valid without expiration. Improvement Permit with site plan valid for sixty months. Authorization to Construct is valid for a period equal to that of Improvement Permit – not to exceed sixty months

Signed: ____ date ____ Installed by ____

Improvement Permit by: ____ date ____ Operation Permit by [redacted] date ____

Authorization to Construct by: ____ date ____ Existing System Inspection by: STEVE HENDRICK date 5-14-02

HEALTH DEPT COPY: WHITE OWNER COPY (FINAL): YELLOW OWNER COPY (INITIAL): PINK