IREDELL COUNTY HEALTH DEPARTMENT

STATESVILLE 704-878-5305 MOORESVILLE 704-664-5281

IMPROVEMENT PERMIT / AUTHORIZATION TO CONSTRUCT / OPERATION PERMIT / EXISTING SYSTEM INSPECTION

PERMIT# 077488 PIN# 4778 07 5063 (PART) DATE 11-12-98

OWNER OR CONTRACTOR BRIAN CALL PHONE: Business Home

ADDRESS 108 TOHOE LANE, TROUTMAN, NC 28166

LOCATION US 21 NORTH, TR CHIEF THOMAS, TR HARMONY BLVD, LOT AT CUL-DE-SAC ON RIGHT

SUBDIVISION EASTEN ACRES BLOCK / SECTION II LOT 17 LOT AREA 0.74 ACRE SITE CLASS. PSI DESIGN FLOW 360 L.T.A.R. 0.30 GPD/FT²

Septic Tank: 1000 Gallons; STB 1012 Date 9-16-98

Pump Tank: Gallons: PT Date

Pump Make: Model Serial No.

Nitrification Field: No Fields 1 Square Feet 1200 Linear Feet 400

No Lines FOUR Trench Width 36" Max Trench Bottom Depth 36" Gravel Depth 12"

☑ New System ☐ Repair System Type: I, (II), III, IV, V, VI

System Description: CONVENTIONAL GRAVITY

Repair System Description: 25% REDUCTION GRAVITY

Maintenance Agreement Required: ☐ Yes ☑ No

☐ House/Mod. Home ☑ Mobile Home ☐ Business ☐ Other

No. Bedrooms 3 No. Bathrooms 2 No. Employees


☐ Slab ☑ Crawl Space ☐ Basement w/plumbing ☐ Basement wo/plumbing

Water Supply: ☑ Individual ☐ Public ☐ Community WELL


Comments:/Conditions: ① KEEP SYSTEM MAXIMUM FEASIBLE DISTANCE (95 FEET) FROM WELL ② CONSTRUCT SUBSURFACE DRAINAGE DITCH AT LOCATION SHOWN BEGINNING 42" DEEP OUT TO DAYLIGHT

Comments:/Conditions: TANK & LINES INSPECTED 11-19-98 SUBSURFACE INTERCEPT DRAIN REMAINS TO BE INSTALLED

INITIAL SITE SKETCH SCALE: 1"=40'

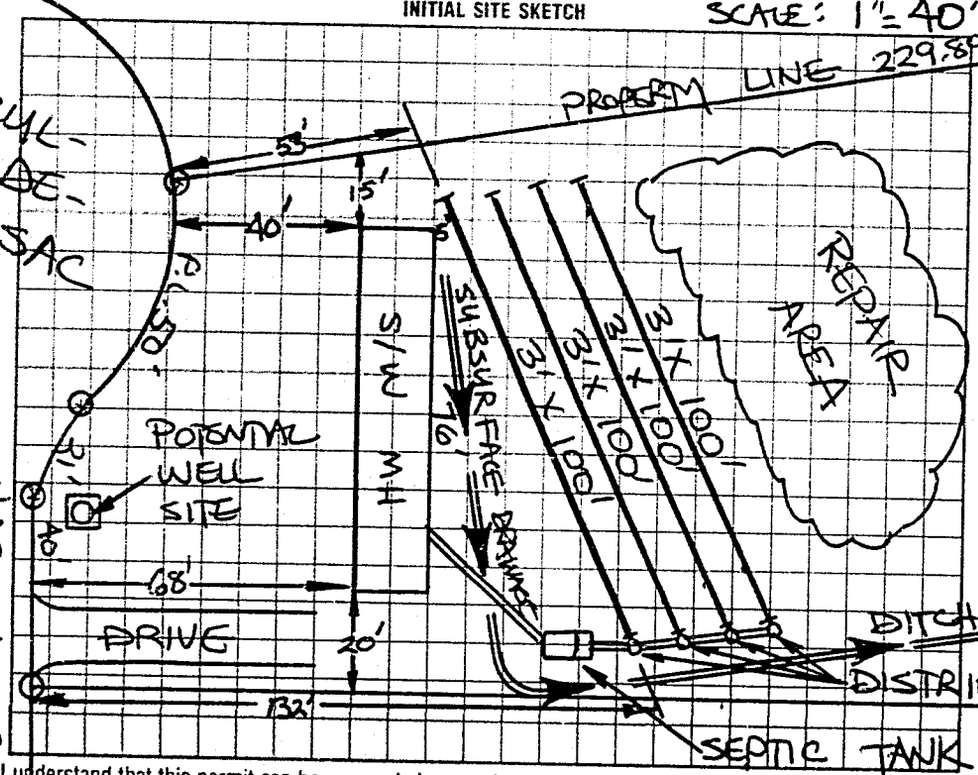

AS BUILT SKETCH

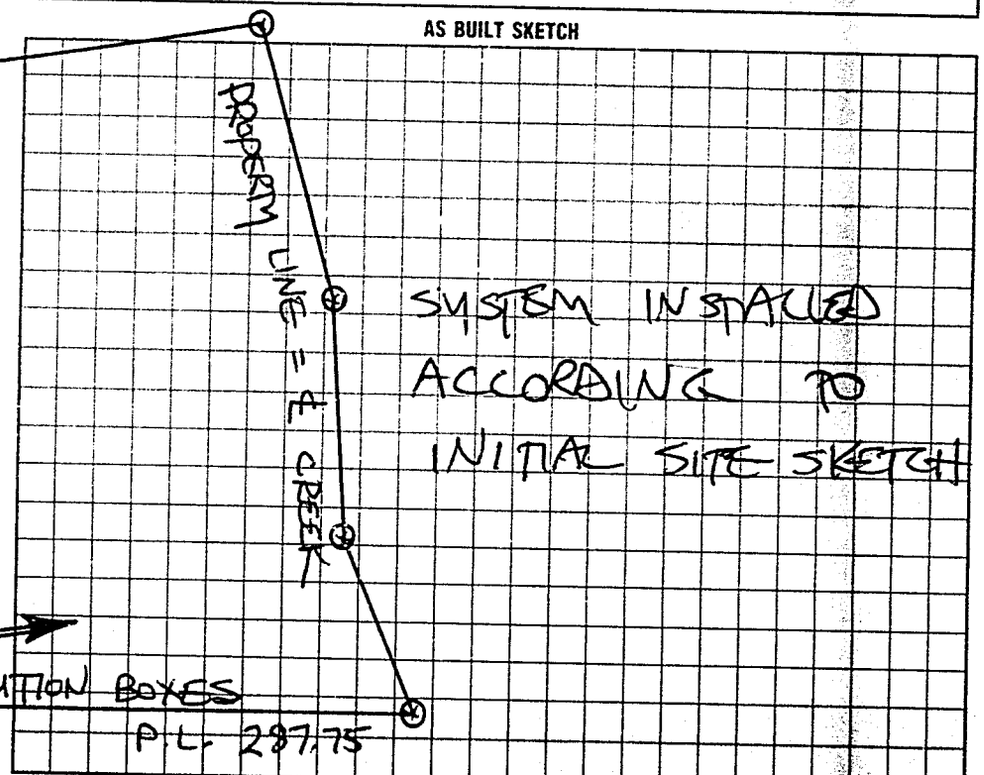

I understand that this permit can be suspended or revoked if any false information is supplied toward securing the permit/any unauthorized changes are made to the site/any unauthorized changes are made in the installation of the system. Improvement Permit with plat valid without expiration. Improvement Permit with site plan valid for sixty months. Authorization to Construct is valid for a period equal to that of Improvement Permit – not to exceed sixty months.

Signed: Claudette Ballard date 11-13-98

Improvement Permit by: STEVE HEDRICK date 11-12-98

Authorization to Construct by: STEVE HEDRICK date 11-12-98

Installed by: KENNY MADISON

Operation Permit by: STEVE HEDRICK date 11-25-98

Existing System Inspection by: date

HEALTH DEPT COPY: WHITE INSPECTION COPY (FINAL): GREEN OWNER COPY (FINAL): YELLOW INSPECTION COPY (INITIAL): PINK OWNER COPY (INITIAL): GOLD