IREDELL COUNTY HEALTH DEPARTMENT

STATESVILLE 704-878-5305 MOORESVILLE 704-664-5281

IMPROVEMENT PERMIT / AUTHORIZATION TO CONSTRUCT / OPERATION PERMIT / EXISTING SYSTEM INSPECTION

PERMIT# 077487 PIN# 4778 07 5063 (PT) DATE 11-17-98

OWNER OR CONTRACTOR JOSEPH BAILEY PHONE: Business Home

ADDRESS 225 CLEMENTS ROAD, STATESVILLE NC 28677

LOCATION US 21 N, TR CHIEF THOMAS, TR HARMONY BLEND, NEXT TO LAST LOT ON RIGHT

SUBDIVISION EASTEN ACRES BLOCK / SECTION II LOT 16 LOT AREA 0.86 ACRE SITE CLASS PS DESIGN FLOW 360 L.T.A.R. 0.25 GPD/FT²

Septic Tank: 1000 Gallons; STB 1012 Date 9-19-98
Pump Tank: Gallons; PT Date
Pump Make: Model Serial No.
Nitrification Field: No Fields Square Feet 660 TO 1440 Linear Feet 240
No Lines SIX Trench Width 24" Max Trench Bottom Depth 36"

☑ New System ☐ Repair System Type: I, II, ☑ III, IV, V, VI
System Description: PPBPS GRAVITY
Repair System Description: PPBPS, LOW PRESSURE
Maintenance Agreement Required: ☐ Yes ☑ No
~~Gravel~~ Depth SAND 6" ☐ Slab ☑ Crawl Space ☐ Basement w/plumbing ☐ Basement wo/plumbing


☐ House/Mod. Home ☑ Mobile Home ☐ Business ☐ Other
No. Bedrooms 3 No. Bathrooms 2 No. Employees

Water Supply: ☐ Individual ☑ Public ☐ Community


Comments:/Conditions: ① INSTALL 54 PPBPS PANELS IN SIX EQUAL LENGTH LINES ON CONTOUR AS SHOWN ② CONSTRUCT SUBSURFACE INTERCEPT DRAINAGE DITCH AS SHOWN BEGINNING 48" DEEP OUT TO DAYLIGHT

Comments:/Conditions: SYSTEM INSTALLED ACCORDING TO INITIAL SITE SKETCH

INITIAL SITE SKETCH

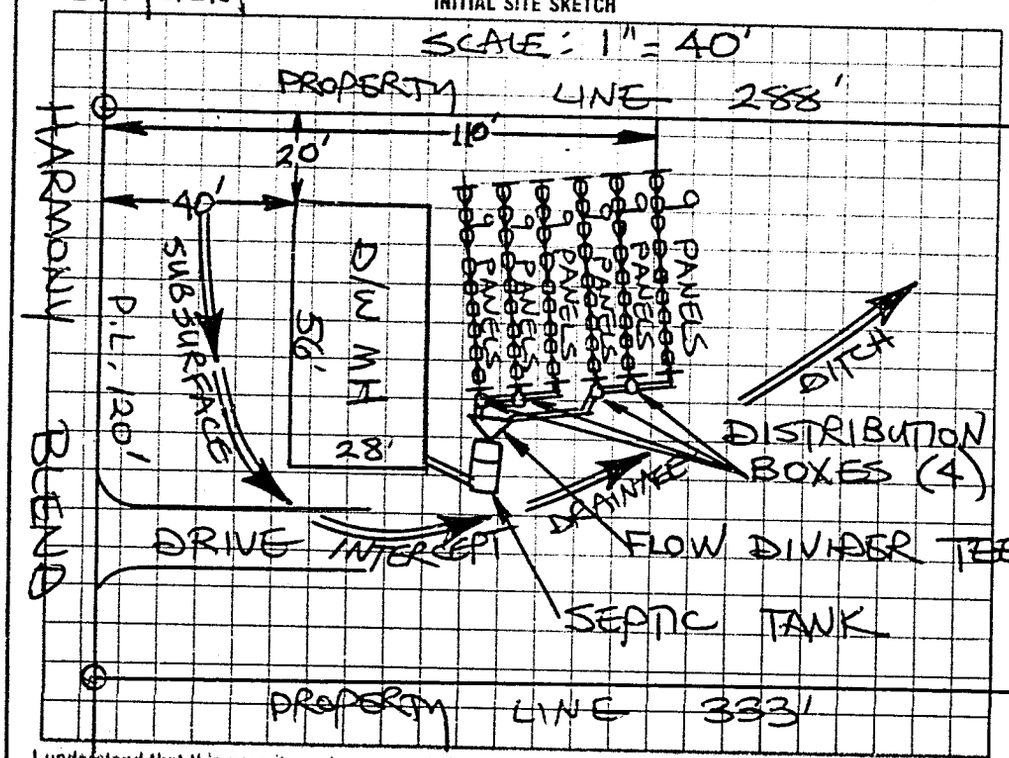

AS BUILT SKETCH

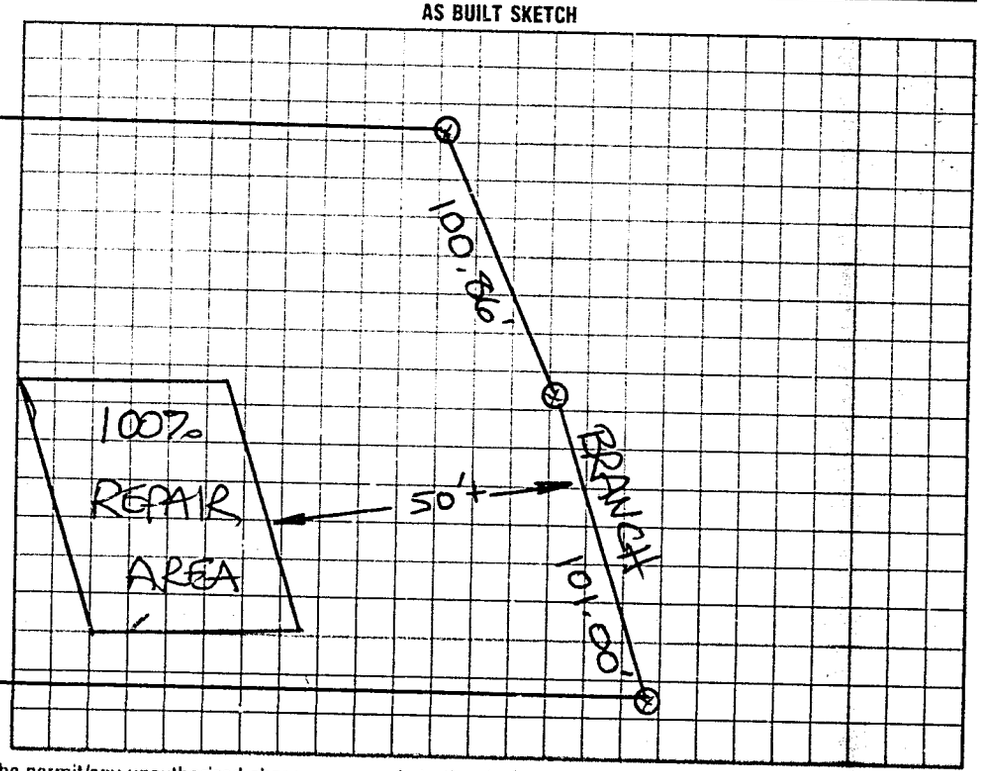

I understand that this permit can be suspended or revoked if any false information is supplied toward securing the permit/any unauthorized changes are made to the site/any unauthorized changes are made in the installation of the system. Improvement Permit with plat valid without expiration. Improvement Permit with site plan valid for sixty months. Authorization to Construct is valid for a period equal to that of Improvement Permit – not to exceed sixty months.

Signed: Claudette Ballard date 11-18-98

Improvement Permit by: STEVE HEDRICK date 11-17-98

Authorization to Construct by: STEVE HEDRICK date 11-17-98

Installed by: KENNY MADISON

Operation Permit by: STEVE HEDRICK date 11-25-98

Existing System Inspection by date

HEALTH DEPT. COPY WHITE INSPECTION COPY (FINAL): GREEN OWNER COPY (FINAL): YELLOW INSPECTION COPY (INITIAL): PINK OWNER COPY (INITIAL): GOLD