IREDELL COUNTY HEALTH DEPARTMENT

STATESVILLE 704-878-5305 MOORESVILLE 704-664-5281

IMPROVEMENT PERMIT / AUTHORIZATION TO CONSTRUCT / OPERATION PERMIT / EXISTING SYSTEM INSPECTION

PERMIT# 082256 PIN# 4778 07 4235 DATE 7-10-99

OWNER OR CONTRACTOR AMERICAN LAND PHONE: Business 878-9595 Home

ADDRESS 1281 GARNER BAGNAL BLVD, STATESVILLE, NC 28677

LOCATION US 21 NORTH, TR CHIEF THOMAS, TR HARMONY BLEND, LOT ON RIGHT NEAR END

SUBDIVISION EASTON ACRES BLOCK / SECTION II LOT 15 LOT AREA 0.99 ACRE SITE CLASS P3 DESIGN FLOW 360 L.T.A.R. 0.30 GPD/FT²

Septic Tank: 1000 Gallons; STB 1012 Date 5-15-99
Pump Tank: Gallons; PT Date
Pump Make: Model Serial No.
Nitrification Field: No Fields 1 Square Feet EQ. TO 1200 Linear Feet 300'
No Lines FOUR Trench Width 36" Max Trench Bottom Depth 36" Gravel Depth SAND 6"

☑ New System ☐ Repair System Type: I, II, (III), IV, V, VI
System Description: 25% REDUCTION, GRAVITY
Repair System Description: 25% REDUCTION, GRAVITY
Maintenance Agreement Required: ☐ Yes ☑ No


☐ House/Mod. Home No. Bedrooms 3
☐ Mobile Home No. Bathrooms 2
☐ Business No. Employees
☐ Other
☐ Slab ☐ Crawl Space ☐ Basement w/plumbing ☐ Basement wo/plumbing

Water Supply: (●) Individual ☐ Public ☐ Community WELL


Comments/Conditions: INSTALL 25% REDUCTION SYSTEM USING FIFTY (50) CHAMBERS OR THIRTY (30) HDS SECTIONS ② KEEP SYSTEM MINIMUM 100 FEET FROM WELL

Comments/Conditions:

INITIAL SITE SKETCH

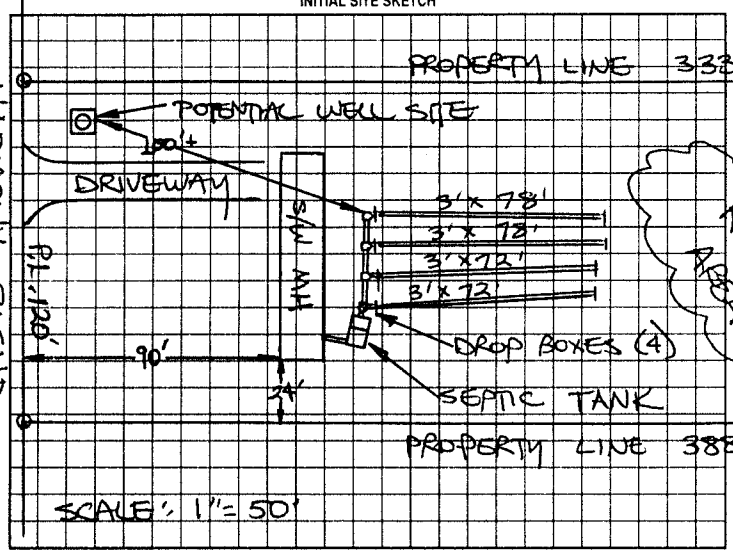

AS BUILT SKETCH

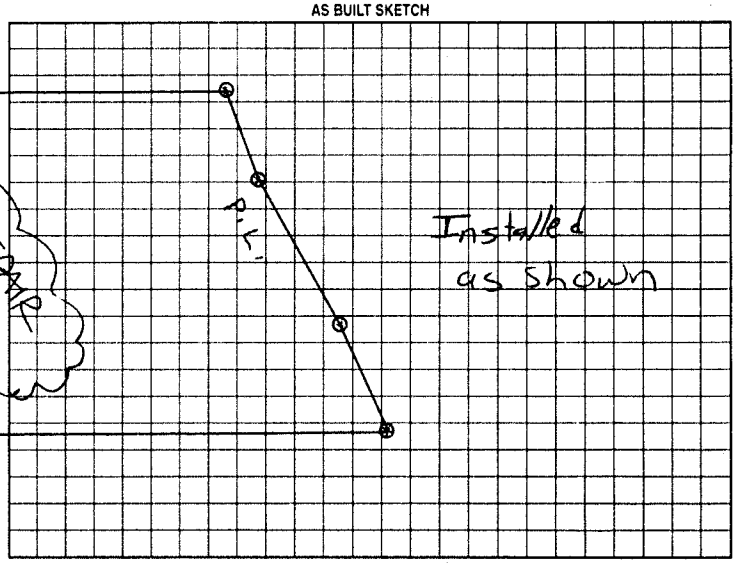

Permit can be suspended or revoked if any false information is supplied toward securing the permit/any unauthorized changes are made to the site/any unauthorized changes are made in the installation of the system. Improvement Permit with plat valid without expiration. Improvement Permit with site plan valid for sixty months. Authorization to Construct is valid for a period equal to that of Improvement Permit - not to exceed sixty months.

Signed: X date 7-12-99 Installed by: A-1 Backhoe

Improvement Permit by: STEVE HEDRICK date 7-10-99 Operation Permit by: Mary C Dail RS date 7-15-99

Authorization to Construct by: STEVE HEDRICK date 7-10-99 Existing System Inspection by: date

HEALTH DEPT COPY WHITE OWNER COPY (FINAL) YELLOW OWNER COPY (INITIAL) PINK