IREDELL COUNTY HEALTH DEPARTMENT

STATESVILLE 704-878-5305 MOORESVILLE 704-664-5281 (C1)

IMPROVEMENT PERMIT / AUTHORIZATION TO CONSTRUCT / OPERATION PERMIT / EXISTING SYSTEM INSPECTION

PERMIT# 106425 PIN# 4778-07-4235 DATE 5-22-02

OWNER OR CONTRACTOR AMERICAN LAND CORPORATION PHONE Business Home 704-528-0848

ADDRESS 198 HARMONY BLEND DR STATESVILLE, NC 28625

LOCATION US 21 N, TR CHIEF, THOMAS RD, TR HARMONY BLEND, LOT # 15 NEAR END ON RIGHT

SUBDIVISION EASTON ACRES BLOCK / SECTION II LOT 15 LOT AREA 0.99 ACRE SITE CLASS PS DESIGN FLOW 360 L.T.A.R. 0.30 GPD/FT²

Septic Tank: 1000 Gallons: STB 1012 Date 5-15-99
Pump Tank: ____ Gallons: PT ____ Date ____
Pump Make: ____ Model ____ Serial No ____
Nitrification Field: No Fields 1 Square Feet EQ TO 1200 Linear Feet 300
No Lines FOUR Trench Width 36" Max Trench Bottom Depth 36" ~~Gravel~~ Depth SAND 6"

☐ New System ☐ Repair System Type: I II (III) IV V VI
System Description: 25% REDUCTION, GRAVITY
Repair System Description: 25% REDUCTION, GRAVITY
Maintenance Agreement Required: ☐ Yes ~~No~~


☑ House/Mod Home No Bedrooms 3
☑ Mobile Home No Bathrooms 2
☐ Business No Employees ____
☐ Other ____
☐ Slab ☑ Crawl Space ☐ Basement w/plumbing ☐ Basement wo/plumbing

Water Supply: ~~Individual~~ ☐ Public ☐ Community WELL


Comments/Conditions:

Comments/Conditions

INITIAL SITE SKETCH

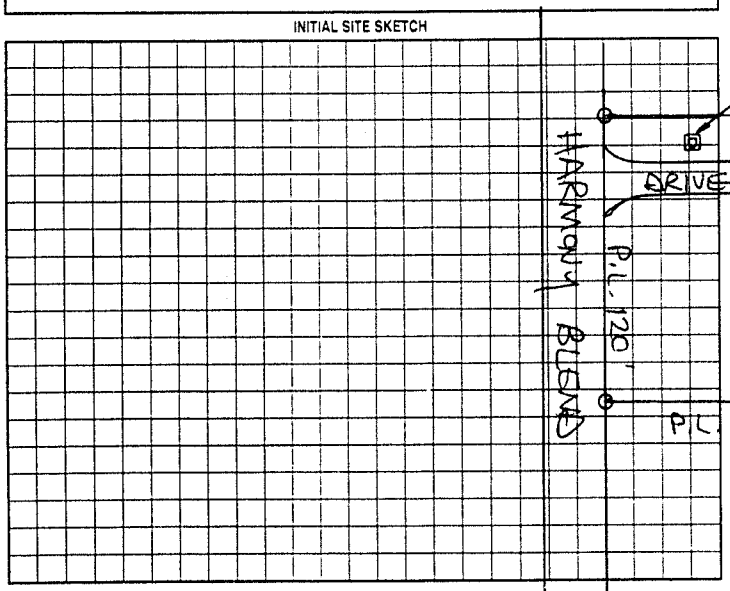

AS BUILT SKETCH

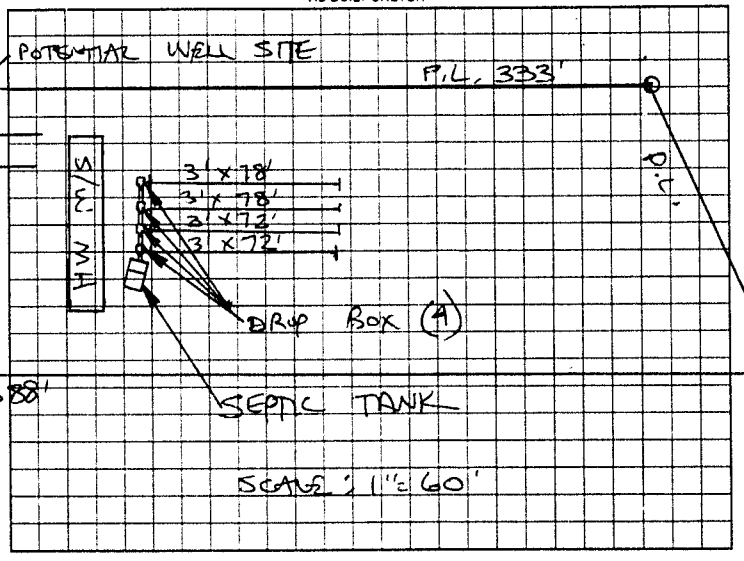

Permit can be suspended or revoked if any false information is supplied toward securing the permit/any unauthorized changes are made to the site any unauthorized changes are made in the installation of the system. Improvement Permit with plat valid without expiration. Improvement Permit with site plan valid for sixty months. Authorization to Construct is valid for a period equal to that of Improvement Permit – not to exceed sixty months

Signed: ____ date ____ Installed by ____

Improvement Permit by: ____ date ____ Operation Permit by ____ date ____

Authorization to Construct by: ____ date ____ Existing System Inspection by: STEVE HEDRICK date 5-22-02

HEALTH DEPT. COPY: WHITE OWNER COPY (FINAL): YELLOW OWNER COPY (INITIAL): PINK