IREDELL COUNTY HEALTH DEPARTMENT

STATESVILLE 704-878-5305 MOORESVILLE 704-664-5281

IMPROVEMENT PERMIT / AUTHORIZATION TO CONSTRUCT / OPERATION PERMIT / EXISTING SYSTEM INSPECTION

PERMIT# 111585 PIN# 4778-07-5334 DATE 03/19/03

OWNER OR CONTRACTOR YANI AGUILER PHONE: Business ~~X~~ 336-751-1273 Home 704-450-2433

ADDRESS 507 COVE GAP STATESVILLE, NC 28625

LOCATION HWY 21 NORTH, (R) CHIEF THOMAS, (R) HARMONY BLEND, ~0.3 MILES ON RIGHT.

SUBDIVISION EASTEN ACRES BLOCK / SECTION ____ LOT 14 LOT AREA 1.11 ACRES SITE CLASS EXISTING DESIGN FLOW 360 GPD L.T.A.R. EXISTING 0.30

Septic Tank: 1,000 Gallons; STB 1012 Date 4/13/97
Pump Tank: ____ Gallons; PT ____ Date ____
Pump Make: ____ Model ____ Serial No. ____
Nitrification Field: No Fields 1 Square Feet EQ to 1,200 Linear Feet 300
No Lines 5 @ 60' Trench Width 36" Max Trench Bottom Depth 36" Gravel Depth ____

☐ New System ☐ Repair System Type: I, II, (III), IV, V, VI
System Description: EXISTING; 25% REDUC.
Repair System Description: ____
Maintenance Agreement Required: ☐ Yes ☒ No


☐ House/Mod. Home No. Bedrooms 3
☒ Mobile Home No. Bathrooms 2
☐ Business No. Employees ____
☐ Other ____
☐ Slab ☒ Crawl Space ☐ Basement w/plumbing ☐ Basement wo/plumbing

Water Supply: ☒ Individual ☐ Public ☐ Community EXISTING WELL


Comments:/Conditions:
* EXISTING SYSTEM INSPECTION *

Comments:/Conditions:

INITIAL SITE SKETCH

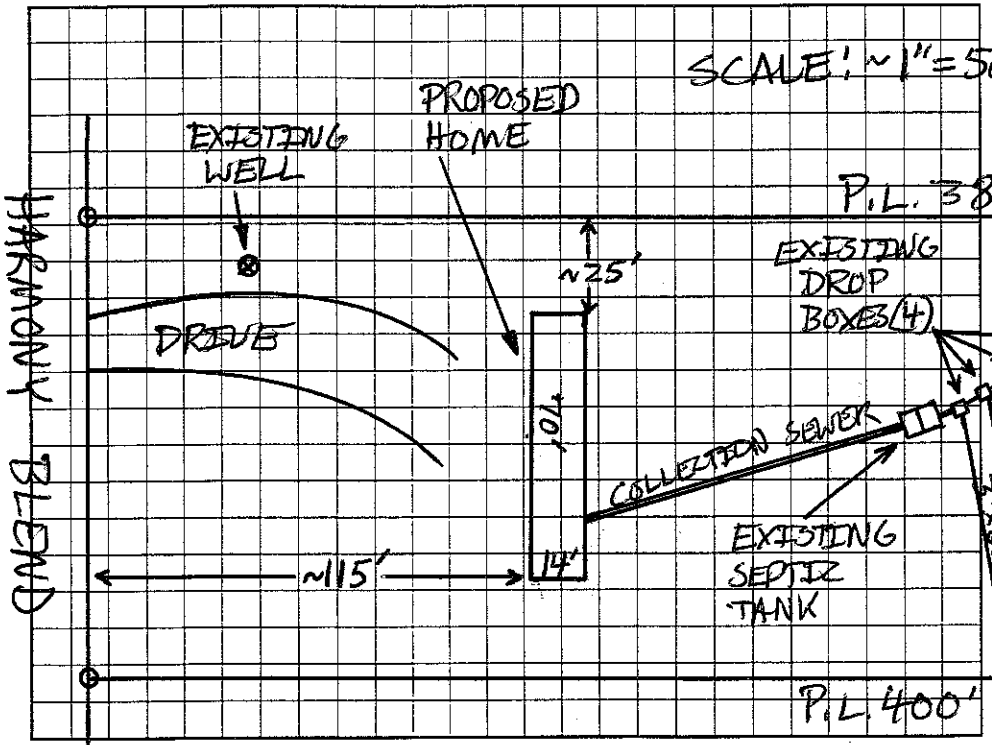

AS BUILT SKETCH

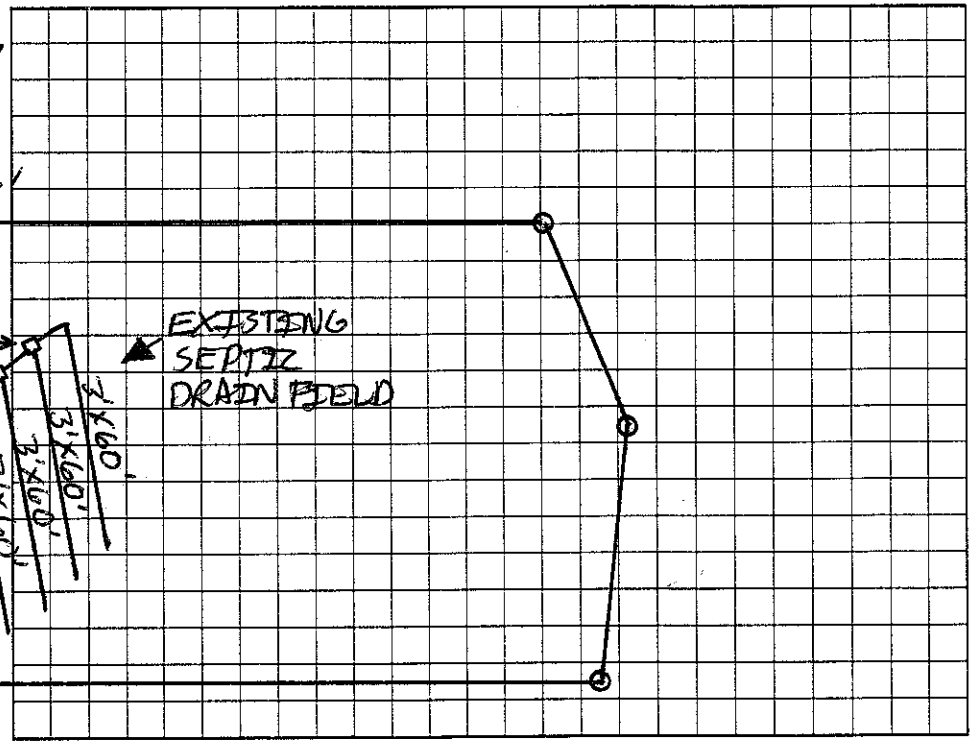

Permit can be suspended or revoked if any false information is supplied toward securing the permit/any unauthorized changes are made to the site/any unauthorized changes are made in the installation of the system. Improvement Permit with plat valid without expiration. Improvement Permit with site plan valid for sixty months. Authorization to Construct is valid for a period equal to that of Improvement Permit – not to exceed sixty months.

X Signed: [signature] date 3/19/03 Installed by: ____

Improvement Permit by: ____ date ____ Operation Permit by: ____ date ____

Authorization to Construct by: ____ date ____ Existing System Inspection by: Patrick Mitchell date 03/19/03

HEALTH DEPT. COPY: WHITE OWNER COPY (FINAL): YELLOW OWNER COPY (INITIAL): PINK