IREDELL COUNTY HEALTH DEPARTMENT

STATESVILLE 704-878-5305 MOORESVILLE 704-664-5281

IMPROVEMENT PERMIT / AUTHORIZATION TO CONSTRUCT / OPERATION PERMIT / EXISTING SYSTEM INSPECTION

PERMIT# 081086 PIN# 4778 07 5334 DATE 5-24-99

OWNER OR CONTRACTOR RONALD GRIFFITH PHONE: Business Home 528-1521

ADDRESS 184 LONGBRANCH ROAD STATESVILLE NC 28677

LOCATION US 21 N, TR CHIEF THOMAS, TR HARMONY BLEND, ~~LEFT~~ ON RIGHT ~ 0.3 Miles RH

SUBDIVISION EASTERN ACRES BLOCK / SECTION LOT 14 LOT AREA 1.11 ACRES SITE CLASS PS DESIGN FLOW 360 L.T.A.R. 0.30 gpd/ft²

Septic Tank: 1000 Gallons; STB 1012 Date 4-13-99

Pump Tank: Gallons; PT Date

Pump Make: Model Serial No.

Nitrification Field: No Fields 1 Square Feet EQ.To 1200 linear Feet 300+

No Lines FIVE Trench Width 36" Max Trench Bottom Depth 36" ~~Gravel~~ Depth SAND 6"

☑ New System ☐ Repair System Type: I, II, III, IV, V, VI

System Description: 25% REDUCTION GRAVITY

Repair System Description: 25% REDUCTION GRAVITY

Maintenance Agreement Required: ☐ Yes ☑ No

☐ House/Mod. Home ☑ Mobile Home ☐ Business ☐ Other

No. Bedrooms 3 No. Bathrooms 2 No. Employees


☐ Slab ☑ Crawl Space ☐ Basement w/plumbing ☐ Basement wo/plumbing

Water Supply: ☑ Individual ☐ Public ☐ Community WELL


Comments/Conditions: INSTALL 25% REDUCTION SYSTEM USING FIFTY (50) CHAMBERS OR THIRTY-SIX (36) HDS SECTIONS ② KEEP SYSTEM MINIMUM 100 FEET FROM WELL.

Comments/Conditions: HDS Sections used

INITIAL SITE SKETCH

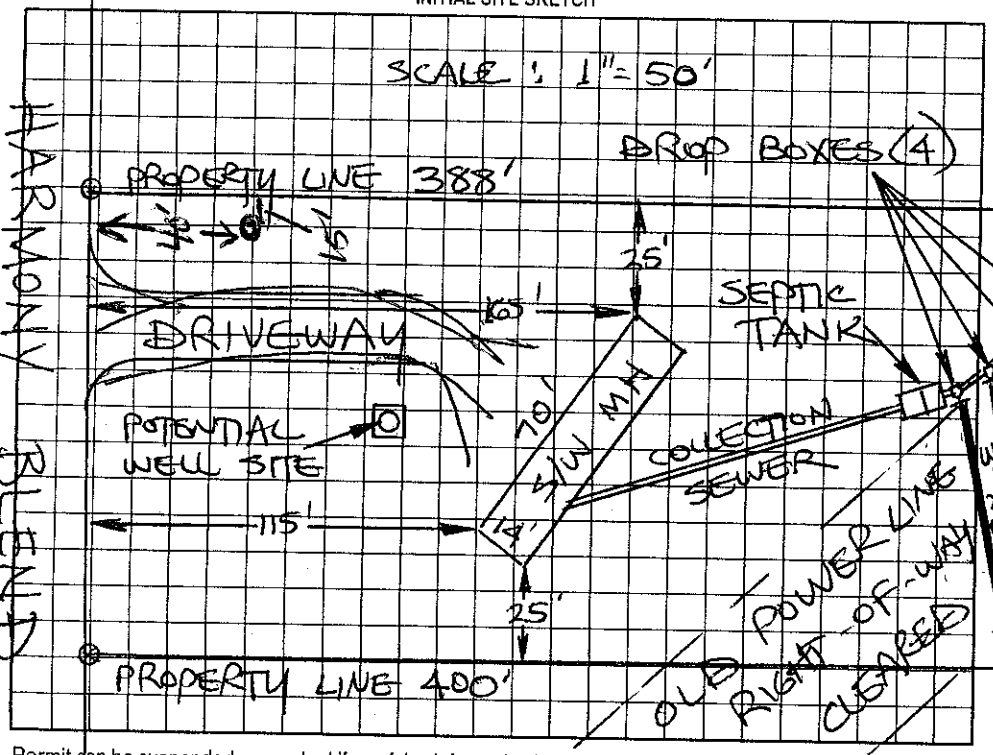

AS BUILT SKETCH

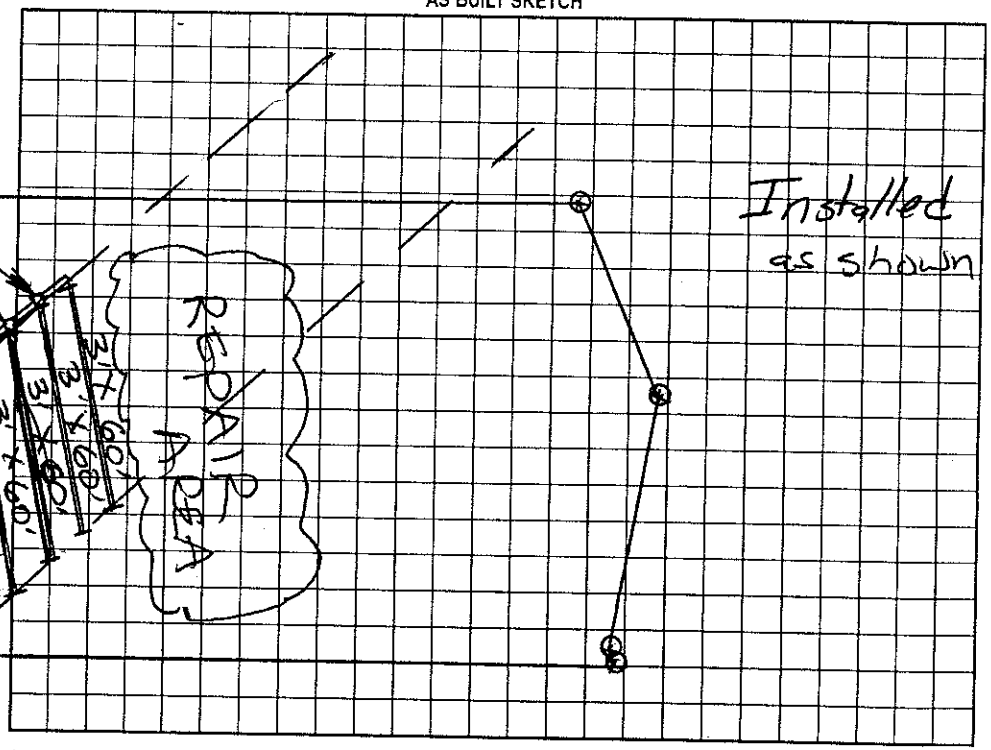

Permit can be suspended or revoked if any false information is supplied toward securing the permit/any unauthorized changes are made to the site/any unauthorized changes are made in the installation of the system. Improvement Permit with plat valid without expiration. Improvement Permit with site plan valid for sixty months. Authorization to Construct is valid for a period equal to that of Improvement Permit – not to exceed sixty months.

Signed: [signature] date 5-24-99 Installed by: A-1 Backhoe

Improvement Permit by: STEVE HEDRICK date 5-24-99 Operation Permit by: Mark C Odom ES date 5-27-99

Authorization to Construct by: STEVE HEDRICK date 5-24-99 Existing System Inspection by: date

HEALTH DEPT. COPY: WHITE OWNER COPY (FINAL): YELLOW OWNER COPY (INITIAL): PINK