IREDELL COUNTY HEALTH DEPARTMENT

STATESVILLE 704-878-5305 MOORESVILLE 704-664-5281

IMPROVEMENT PERMIT / AUTHORIZATION TO CONSTRUCT / OPERATION PERMIT / EXISTING SYSTEM INSPECTION

PERMIT# 088053 PIN# 4778 07 7584 DATE 3-14-00

OWNER OR CONTRACTOR WILLIAM MARLOWE PHONE: Business 838-0755 Home

ADDRESS 124 EMMA LANE, STATESVILLE, NC 28625

LOCATION US 21 NORTH, TR CHIEF THOMAS ROAD, TR HARMONY BLVD, 12TH LOT ON RIGHT

SUBDIVISION EASTERN ACRES BLOCK / SECTION II LOT 12 LOT AREA 1.88 ACRES SITE CLASS PS DESIGN FLOW 360 L.T.A.R. 0.25 GPD/FT²

Septic Tank: 1000 Gallons; STB 1012 Date 11-29-99
Pump Tank: Gallons; PT Date
Pump Make: Model Serial No.
Nitrification Field: No Fields 1 Square Feet 60, no 1990 Linear Feet 240
No Lines SIX Trench Width 24" Max Trench Bottom Depth 36" Depth SAND 6'

☑ New System ☐ Repair System Type: I, II, III, IV, V, VI
System Description: 50% REDUCTION, PPBPS
Repair System Description: 25% REDUCTION, PUMP
Maintenance Agreement Required: ☐ Yes ☑ No


☐ House/Mod. Home No. Bedrooms 3
☑ Mobile Home No. Bathrooms 2
☐ Business No. Employees
☐ Other
☐ Slab ☑ Crawl Space ☐ Basement w/plumbing ☐ Basement wo/plumbing

Water Supply: ☑ Individual ☐ Public ☐ Community


Comments/Conditions: ① KEEP SYSTEM MAXIMUM FEASIBLE DISTANCE (90') FROM WELL ② INSTALL 50% REDUCTION SYSTEM USING 54 PPBPS PANELS IN SIX EQUAL LENGTH LINES AS FLAGGED. ③ INSTALL SUBSURFACE INTERCEPT DRAINAGE DITCH AS SHOWN BEGINNING 42" DEEP.

Comments/Conditions: SEPTIC TANK W/ RISERS INSTALLED USING "POLY LOK" FILTER

INITIAL SITE SKETCH

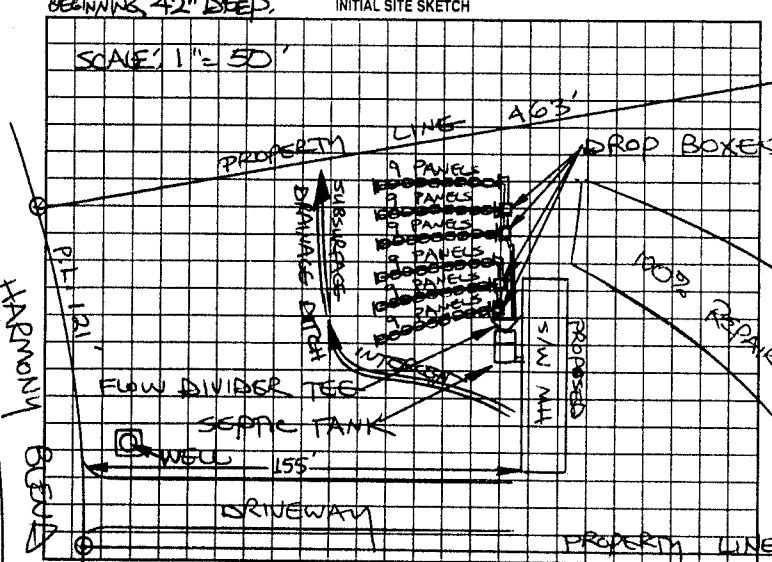

AS BUILT SKETCH

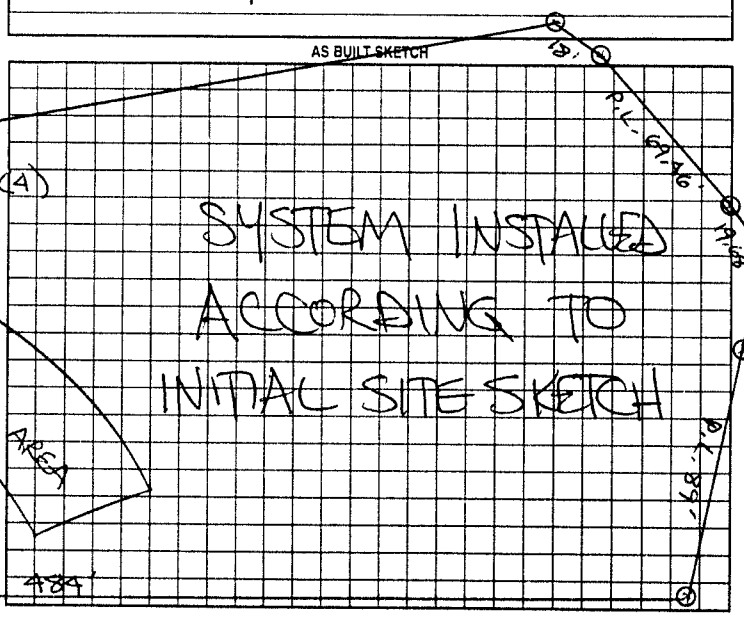

Permit can be suspended or revoked if any false information is supplied toward securing the permit/any unauthorized changes are made to the site/any unauthorized changes are made in the installation of the system. Improvement Permit with plat valid without expiration. Improvement Permit with site plan valid for sixty months. Authorization to Construct is valid for a period equal to that of Improvement Permit – not to exceed sixty months.

Signed: William T Marlow date 3-16-00 Installed by: STEVE JORDAN

Improvement Permit by: STEVE HEDRICK date 3-14-00 Operation Permit by: STEVE HEDRICK date 3-29-00

Authorization to Construct by: STEVE HEDRICK date 3-14-00 Existing System Inspection by: date

HEALTH DEPT. COPY: WHITE OWNER COPY (FINAL): YELLOW OWNER COPY (INITIAL): PINK