IREDELL COUNTY HEALTH DEPARTMENT

STATESVILLE 704-878-5305 MOORESVILLE 704-664-5281

IMPROVEMENT PERMIT / AUTHORIZATION TO CONSTRUCT / OPERATION PERMIT / EXISTING SYSTEM INSPECTION

PERMIT# 083199 PIN# 4778 07 9536 DATE 8-10-99

OWNER OR CONTRACTOR MELESIO MENDEZ PHONE: Business Home 878-1078

ADDRESS 606 MOORESVILLE HWY STATESVILLE, NC 28625

LOCATION US 21 N, TR CHIEF THOMAS RD, TR HARMONY BLEND, LOT # 11 ON RIGHT

SUBDIVISION EASTER ACRES BLOCK / SECTION LOT 11 LOT AREA 1.50 ACRES SITE CLASS PS DESIGN FLOW 360 L.T.A.R. 0.30 GPD/FT²

Septic Tank: 1000 Gallons; STB 1600 Date 10-8-99
Pump Tank: Gallons; PT Date
Pump Make: Model Serial No.
Nitrification Field: No Fields 1 Square Feet 1200 Linear Feet 400
No Lines FOUR Trench Width 36" Max Trench Bottom Depth 36" Gravel Depth 12"

☑ New System ☐ Repair System Type: I II III IV V VI
System Description: CONVENTIONAL GRAVITY
Repair System Description: CONV. GRAVITY
Maintenance Agreement Required: ☐ Yes ☑ No
☐ Slab ☑ Crawl Space ☐ Basement w/plumbing ☐ Basement wo/plumbing


☐ House/Mod. Home No. Bedrooms 3
☑ Mobile Home No. Bathrooms 2
☐ Business No. Employees
☐ Other

Water Supply: ☑ Individual ☐ Public ☐ Community WELL


Comments:/Conditions: KEEP SYSTEM MINIMUM 100 FEET FROM WELL

Comments:/Conditions: ① SEPTIC TANK WITH RISERS INSTALLED USING [redacted] FILTER ② LINES INSTALLED INTO CONTOUR AND UPPER LINES INSTALLED DEEPER THAN 36 INCHES

INITIAL SITE SKETCH

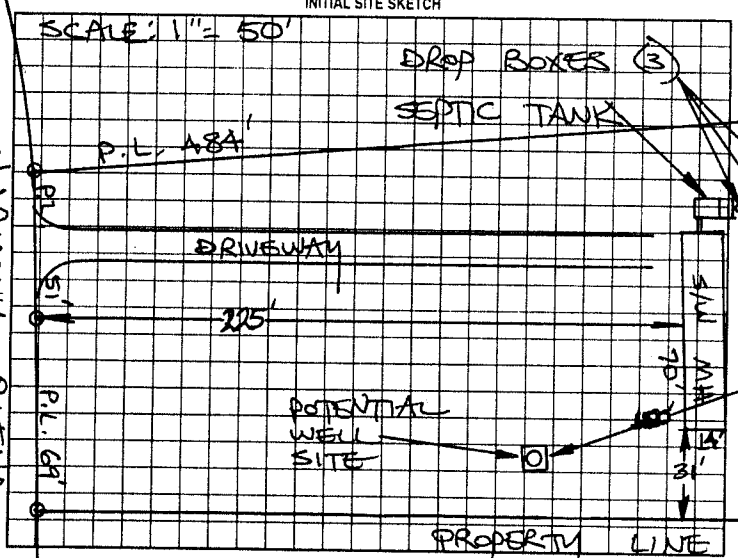

AS BUILT SKETCH

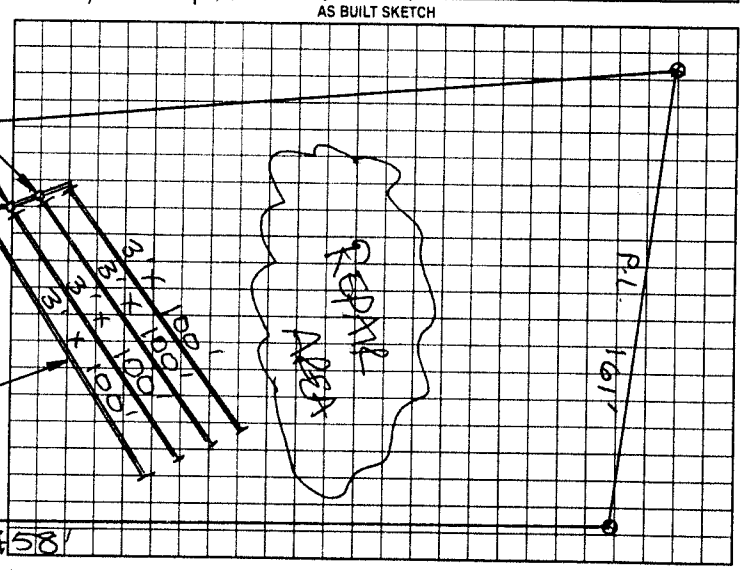

Permit can be suspended or revoked if any false information is supplied toward securing the permit/any unauthorized changes are made to the site/any unauthorized changes are made in the installation of the system. Improvement Permit with plat valid without expiration. Improvement Permit with site plan valid for sixty months. Authorization to Construct is valid for a period equal to that of Improvement Permit – not to exceed sixty months.

Signed: [signature] date 8-10-99 Installed by: BARRY SIGMON

Improvement Permit by: STEVE HEDRICK date 8-10-99 Operation Permit by: STEVE HEDRICK date 11-10-99

Authorization to Construct by: STEVE HEDRICK date 8-10-99 Existing System Inspection by: date

HEALTH DEPT COPY WHITE OWNER COPY (FINAL) YELLOW OWNER COPY (INITIAL) PINK