IREDELL COUNTY HEALTH DEPARTMENT

STATESVILLE 704-878-5305 MOORESVILLE 704-664-5281

IMPROVEMENT PERMIT / AUTHORIZATION TO CONSTRUCT / OPERATION PERMIT / EXISTING SYSTEM INSPECTION

PERMIT# 077853 PIN# 4778 07 5063 (PART) DATE 12-18-98

OWNER OR CONTRACTOR ALTA UPRIGHT PHONE: Business Home (704) 408-7600

ADDRESS 6311 RIGHT ROAD KANNAPOLIS, NC 28081

LOCATION US 31 North, TR CHIEF THOMAS ROAD, TR HARMONY BLEND, on LOT (#26) ON LEFT

SUBDIVISION EASTEN ACRES BLOCK / SECTION LOT 26 LOT AREA 1.67 ACRES SITE CLASS PS DESIGN FLOW 360 L.T.A.R. 0.40 GPD/FT²

Septic Tank: 1000 Gallons: STB 794 Date 11-4-98
Pump Tank: Gallons: PT Date
Pump Make: Model Serial No
Nitrification Field: No Fields 1 Square Feet 900 Linear Feet 300
No Lines FOUR Trench Width 36" Max Trench Bottom Depth 36"

✓ New System Repair System Type I II III IV V
System Description CONVENTIONAL GRAVITY
Repair System Description CONV. GRAVITY
Maintenance Agreement Required Yes ✓ No
Gravel Depth 12" Stone ✓ Gravel Space Basement w/plumbing Basement w/o plumbing


✓ House/Mod. Home No. Bedrooms 3
✓ Mobile Home No. Bathrooms 2
Business No. Employees
Other

Water Supply: ✓ Individual ☐ Public ☐ Community
WELL

Comments./Conditions: ① CONSTRUCT SUBSURFACE INTERCEPT DRAINAGE DITCH AT LOCATION SHOWN BEGINNING 48 INCHES DEEP OUT TO DAYLIGHT. ② KEEP SYSTEM MINIMUM 100 FEET FROM WELL.

Required Conditions:

INITIAL SITE SKETCH SCALE: 1" = 50'

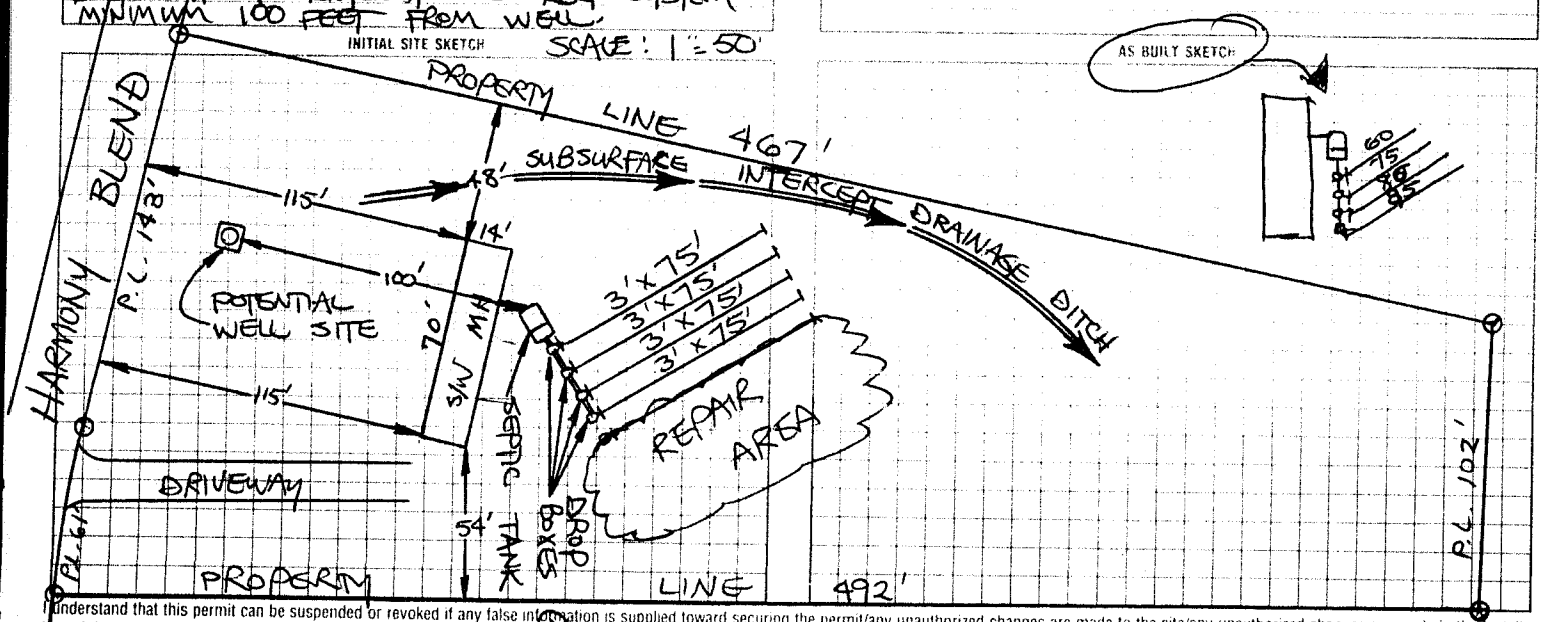

AS BUILT SKETCH

I understand that this permit can be suspended or revoked if any false information is supplied toward securing the permit/any unauthorized changes are made to the site/any unauthorized changes are made in the installation of the system. Improvement Permit with plat valid without expiration. Improvement Permit with site plan valid for sixty months. Authorization to Construct is valid for a period equal to that of Improvement Permit – not to exceed sixty months.

Signed: Claudette Ballard date 12-21-98

Improvement Permit by: STEVE HEDRICK date 12-18-98

Authorization to Construct by: STEVE HEDRICK date 12-18-98

Installed by: JAMES HUDLER

Operation Permit by: STEVE HEDRICK date 2-8-99

Existing System Inspection by: date

HEALTH DEPT. COPY: WHITE INSPECTION COPY (FINAL): GREEN OWNER COPY (FINAL): YELLOW INSPECTION COPY (INITIAL): PINK OWNER COPY (INITIAL): GOLD