IREDELL COUNTY HEALTH DEPARTMENT

STATESVILLE 704-878-5305 MOORESVILLE 704-664-5281

IMPROVEMENT PERMIT / AUTHORIZATION TO CONSTRUCT / OPERATION PERMIT / EXISTING SYSTEM INSPECTION

PERMIT# 120517 PIN# 4778-17-0047 DATE 5-20-04

OWNER OR CONTRACTOR Sixto Silva PHONE: Business Home (704) 876-6042

ADDRESS 397 Jane Sowers Rd Statesville NC 28625

LOCATION 21 N TR Chief Thomas Rd. TR Harmony Blend Rd. Go ~ .3 miles Lot #26 on Left.

SUBDIVISION Eastern Acres BLOCK / SECTION LOT 26 LOT AREA 1.67 SITE CLASS. PS DESIGN FLOW 360 L.T.A.R. Existing

Septic Tank: 1000 Exist Gallons; STB Date

Pump Tank: Gallons; PT Date

Pump Make: Model Serial No.

Nitrification Field: No Fields 1 Square Feet Linear Feet 300 Ex.

No Lines 4 Ex Trench Width Max Trench Bottom Depth Gravel Depth

☐ New System ☐ Repair System Type: I (II) III, IV, V, VI

System Description: Con. Gravity

Repair System Description: Same

Maintenance Agreement Required: ☐ Yes ☐ No

☐ House/Mod. Home No. Bedrooms 3

☑ Mobile Home No. Bathrooms 2

☐ Business No. Employees

☐ Other

☐ Slab ☐ Crawl Space ☐ Basement w/plumbing ☐ Basement wo/plumbing


Water Supply: ☑ Individual ☐ Public ☐ Community Well

Comments:/Conditions:

Comments:/Conditions: ① System functioning properly at time of inspection
② Permission to connect proposed structure onto existing system
③ New system shall not increase the number of bedrooms on system
④ Inspection of system is a visual inspection only. There is no guarantee problems won't arise in future.

INITIAL SITE SKETCH

AS BUILT SKETCH Scale 1"=50

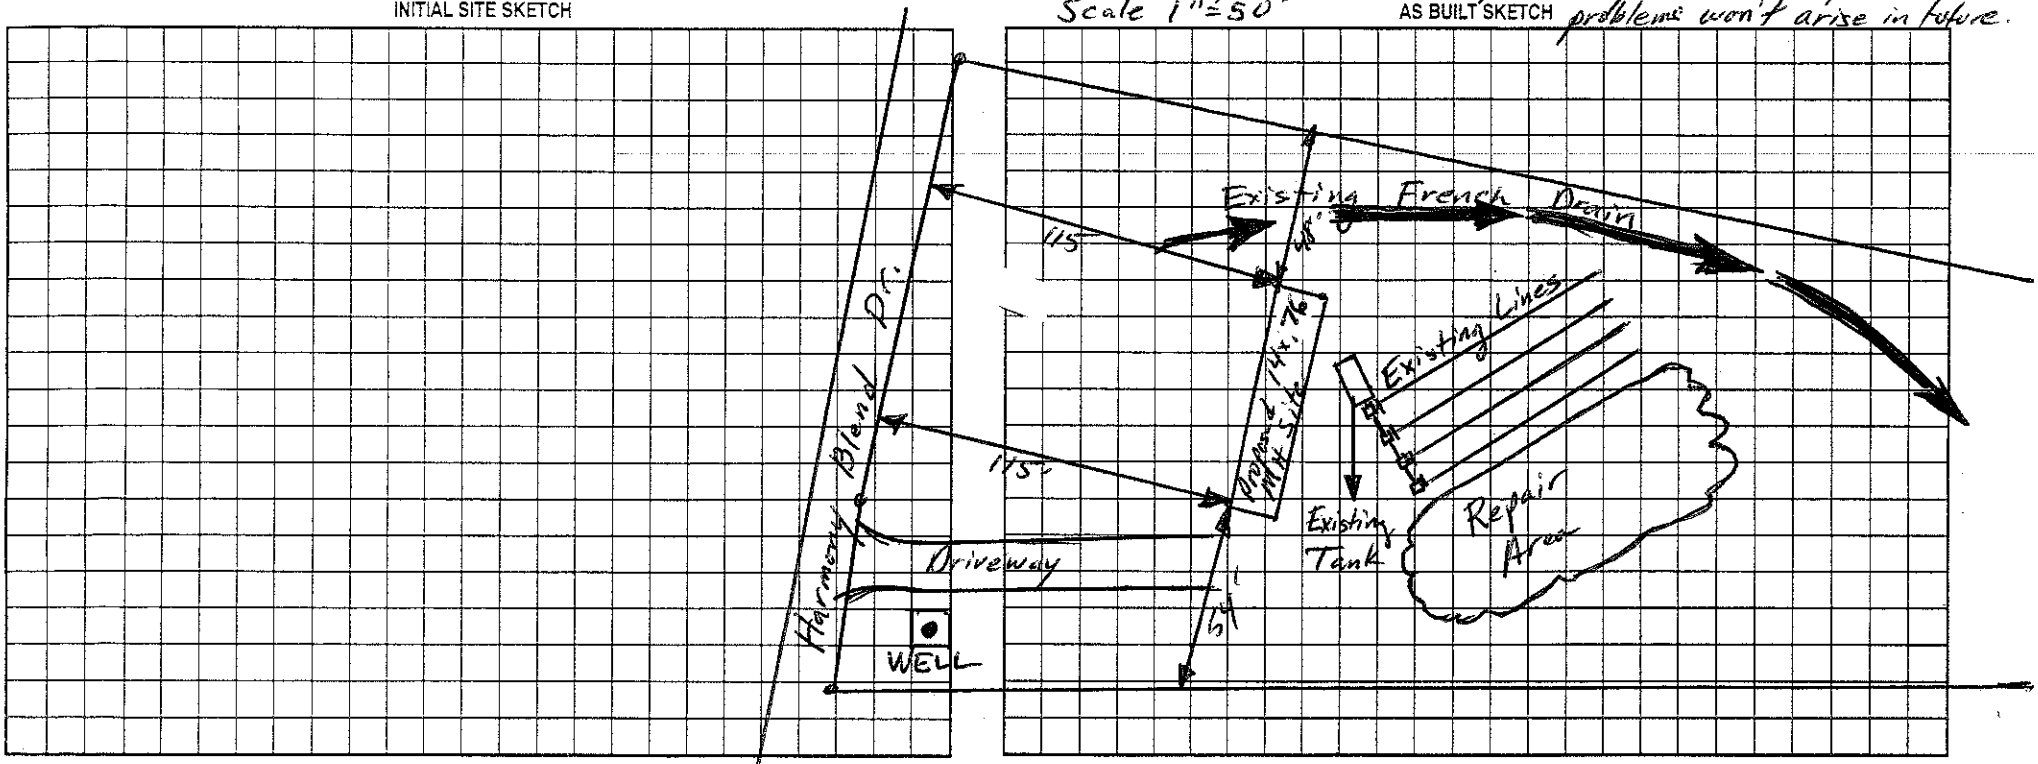

Permit can be suspended or revoked if any false information is supplied toward securing the permit/any unauthorized changes are made to the site/any unauthorized changes are made in the installation of the system. Improvement Permit with plat valid without expiration. Improvement Permit with site plan valid for sixty months. Authorization to Construct is valid for a period equal to that of Improvement Permit – not to exceed sixty months.

Signed: Bobby Cook date 5/20/04 Installed by: James Hudler

Improvement Permit by: date Operation Permit by: date

Authorization to Construct by: date Existing System Inspection by: Christopher M. Smith, RS date 5-20-04

HEALTH DEPT. COPY: WHITE OWNER COPY (FINAL): YELLOW OWNER COPY (INITIAL): PINK