IREDELL COUNTY HEALTH DEPARTMENT

STATESVILLE 704-878-5305 MOORESVILLE 704-664-5281

IMPROVEMENT PERMIT / AUTHORIZATION TO CONSTRUCT / OPERATION PERMIT / EXISTING SYSTEM INSPECTION

PERMIT# 078254 PIN# 4778 07 5063 (PART) DATE 12-18-98

OWNER OR CONTRACTOR ROBERT ASQUITH PHONE: Business Home (704) 408-7600

ADDRESS 97 BORDEN AVE PERRY, NY 14530

LOCATION US 21 NORTH, TR CHIEF THOMAS ROAD, TR HARMONY BLEND DRIVE, 5TH LOT ON LEFT

SUBDIVISION EASTEN ACRES BLOCK / SECTION LOT 27 LOT AREA 1.26 ACRES SITE CLASS PS DESIGN FLOW 360 L.T.A.R. 0.25 GPD/FT²

Septic Tank: 1000 Gallons STB 794 Date 12-16-98
Pump Tank Gallons PT Date
Pump Make: Model Serial No.
Nitrification Field: No Fields 1 Square Feet 1440 Linear Feet 360+
No. Lines SIX Trench Width 36" Max. Trench Bottom Depth 36"

✓ New System Repair System Type C
System Description 25% REDUCTION GRAVITY
Repair System Description 25% REDUCT. GRAVITY
Maintenance Agreement Required Yes No ✓


✓ House/Mod. Home No. Bedrooms 3
Mobile Home No. Bathrooms 2
Business No. Employees
Other
Slab Crawl Space Basement w/plumbing Basement w/o plumbing

Water Supply: ✓ Individual Public Community
WELL


Comments/Conditions: ① INSTALL 25% REDUCTION SYSTEM USING SIXTY (60) CHAMBERS OR THIRTY-SIX (36) HDS SECTIONS ② INSTALL SUBSURFACE INTERCEPT DRAINAGE DITCH & SURFACE DITCH AT LOCATIONS SHOWN.

Comments/Corrections: SURFACE DIVERSION DITCH REMAINS TO BE COMPLETED (1-29-99) ALL ELSE OK.

INITIAL SITE SKETCH

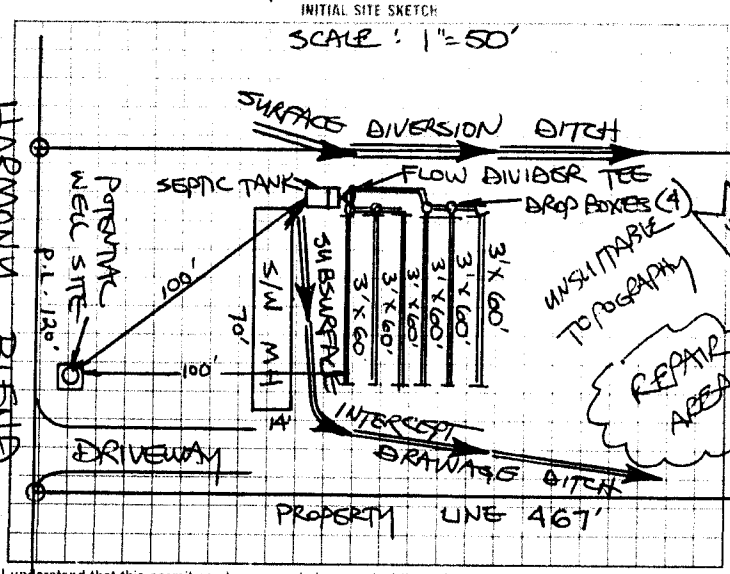

AS BUILT SKETCH

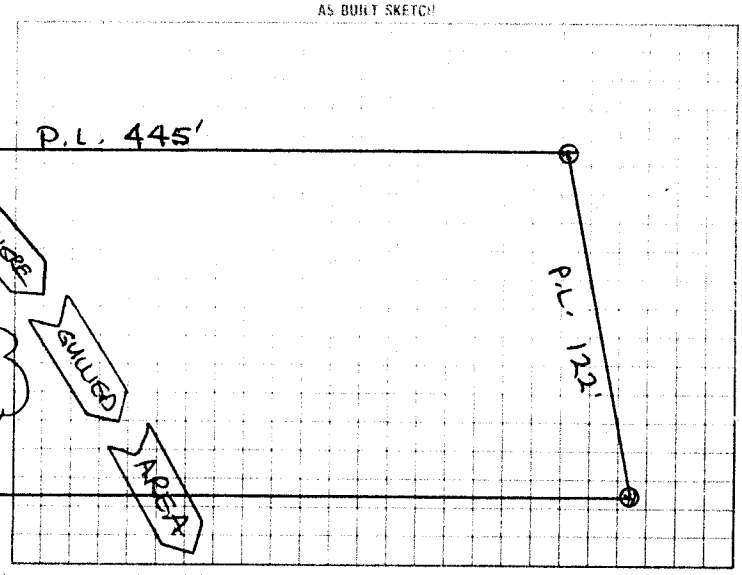

I understand that this permit can be suspended or revoked if any false information is supplied toward securing the permit/any unauthorized changes are made to the site/any unauthorized changes are made in the installation of the system. Improvement Permit with plat valid without expiration. Improvement Permit with site plan valid for sixty months. Authorization to Construct is valid for a period equal to that of Improvement Permit – not to exceed sixty months.

Signed: Claudette Bullard date 12-21-98 Installed by: JAMES HADLER

Improvement Permit by: STEVE HEDRICK date 12-18-98 Operation Permit by: STEVE HEDRICK date 2-8-99

Authorization to Construct by: STEVE HEDRICK date 12-18-98 Existing System Inspection by: date

HEALTH DEPT. COPY WHITE INSPECTION COPY (FINAL) GREEN OWNER COPY (FINAL) YELLOW INSPECTION COPY (INITIAL) PINK OWNER COPY (INITIAL) GOLD