IREDELL COUNTY HEALTH DEPARTMENT

STATESVILLE 704-878-5305 MOORESVILLE 704-664-5281

IMPROVEMENT PERMIT / AUTHORIZATION TO CONSTRUCT / OPERATION PERMIT / EXISTING SYSTEM INSPECTION

PERMIT# 086763 PIN# 4778 17 3101 DATE 12-22-99

OWNER OR CONTRACTOR AMERICAN LAND PHONE: Business 878-9595 Home

ADDRESS 1281 GARNER BAGNAL BLVD, STATESVILLE, NC 28625

LOCATION US 21 N, TR CHIEF THOMAS RD, TR HARMONY BLVD, LOT HALFWAY ON LEFT

SUBDIVISION EASTERN ACRES BLOCK / SECTION LOT 28 LOT AREA 1.20 ACRES SITE CLASS PS DESIGN FLOW 360 L.T.A.R. 0.25 GAD/FT²

Septic Tank: 1000 Gallons; STB 794 Date 8-17-01

Pump Tank: Gallons; PT Date

Pump Make: Model Serial No.

Nitrification Field: No Fields 1 Square Feet EQ. TO 1440 Linear Feet 360+

No Lines FOUR Trench Width 36" Max Trench Bottom Depth 30"

☑ New System ☐ Repair System Type: I, II, (III), IV, V, VI

System Description: 25% REDUCTION GRAVITY

Repair System Description: LOW PRESSURE PIPE

Maintenance Agreement Required: ☐ Yes ☑ No

☐ House/Mod. Home ☐ Mobile Home ☐ Business ☐ Other

No. Bedrooms 3 No. Bathrooms 2 No. Employees


☐ Slab ☐ Crawl Space ☐ Basement w/plumbing ☐ Basement wo/plumbing

Water Supply: ☑ Individual ☐ Public ☐ Community WELL


Comments/Conditions: ① INSTALL 25% REDUCTION SYSTEM USING SIXTY (60) CHAMBERS OR 36 HDS SEEPONS ② KEEP SYSTEM MINIMUM 100 FEET FROM WELL

Comments/Conditions: SEPTIC TANK WITH MARKER INSTALLED USING "ZABEL" FILTER

INITIAL SITE SKETCH SCALE: 1"=50'

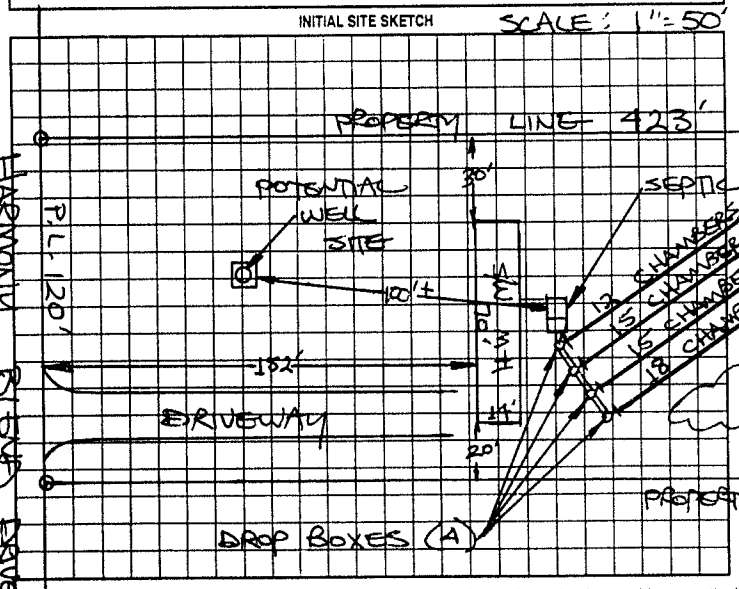

AS BUILT SKETCH

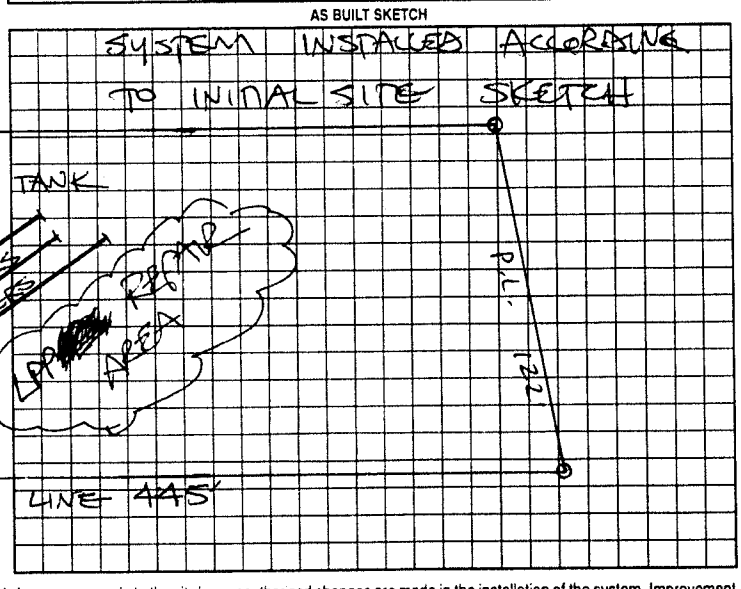

Permit can be suspended or revoked if any false information is supplied toward securing the permit/any unauthorized changes are made to the site/any unauthorized changes are made in the installation of the system. Improvement Permit with plat valid without expiration. Improvement Permit with site plan valid for sixty months. Authorization to Construct is valid for a period equal to that of Improvement Permit – not to exceed sixty months.

Signed: [signature] date 12-23 Installed by: MARTY TUCKER

Improvement Permit by: STEVE HEDRICK date 12-22-99 Operation Permit by: STEVE HEDRICK date 10-18-01

Authorization to Construct by: STEVE HEDRICK date 12-22-99 Existing System Inspection by: date

HEALTH DEPT. COPY: WHITE OWNER COPY (FINAL): YELLOW OWNER COPY (INITIAL): PINK