IREDELL COUNTY HEALTH DEPARTMENT

STATESVILLE 704-878-5305 MOORESVILLE 704-664-5281

IMPROVEMENT PERMIT / AUTHORIZATION TO CONSTRUCT / OPERATION PERMIT / EXISTING SYSTEM INSPECTION

PERMIT# 077489 PIN# 4778 07 5063 (PT) DATE 11-4-98

OWNER OR CONTRACTOR JAMES GIBBS PHONE: Business Home

ADDRESS 2020 RAYON ST, STATESVILLE, NC 28677

LOCATION US 21 NORTH, TR CHIEF THOMAS RD, TR HARMONY BLEND, 8TH LOT ON RIGHT

SUBDIVISION EASTON ACRES BLOCK / SECTION II LOT 8 LOT AREA 1.15 ACRES SITE CLASS PS DESIGN FLOW 360 L.T.A.R. 0.30 gpd/ft²

Septic Tank: 1000 Gallons; STB 794 Date 8-31-98
Pump Tank: Gallons; PT Date
Pump Make: Model Serial No.
Nitrification Field: No Fields 1 Square Feet EQ. TO 1200 Linear Feet 300+
No Lines FIVE Trench Width 36" Max Trench Bottom Depth 36"

☑ New System ☐ Repair System Type: I, II, III, IV, V, VI
System Description: 25% REDUCTION SYSTEM
Repair System Description: 25% REDUCTION
Maintenance Agreement Required: ☐ Yes ☑ No PUMP
~~Gravel~~ Depth SAND 6"

☐ House/Mod. Home ☑ Mobile Home ☐ Business ☐ Other
No. Bedrooms 3 No. Bathrooms 2 No. Employees


☐ Slab ☑ Crawl Space ☐ Basement w/plumbing ☐ Basement wo/plumbing

Water Supply: ☑ Individual ☐ Public ☐ Community


Comments:/Conditions: ① KEEP SYSTEM MINIMUM 100' FROM WELL ② INSTALL 25% REDUCTION SYSTEM USING FIFTY 6' CHAMBERS OR THIRTY H.D.S. SECTIONS.

Comments:/Conditions: SYSTEM INSTALLED ACCORDING TO INITAL SITE SKETCH

SCALE: 1" = 40' INITIAL SITE SKETCH

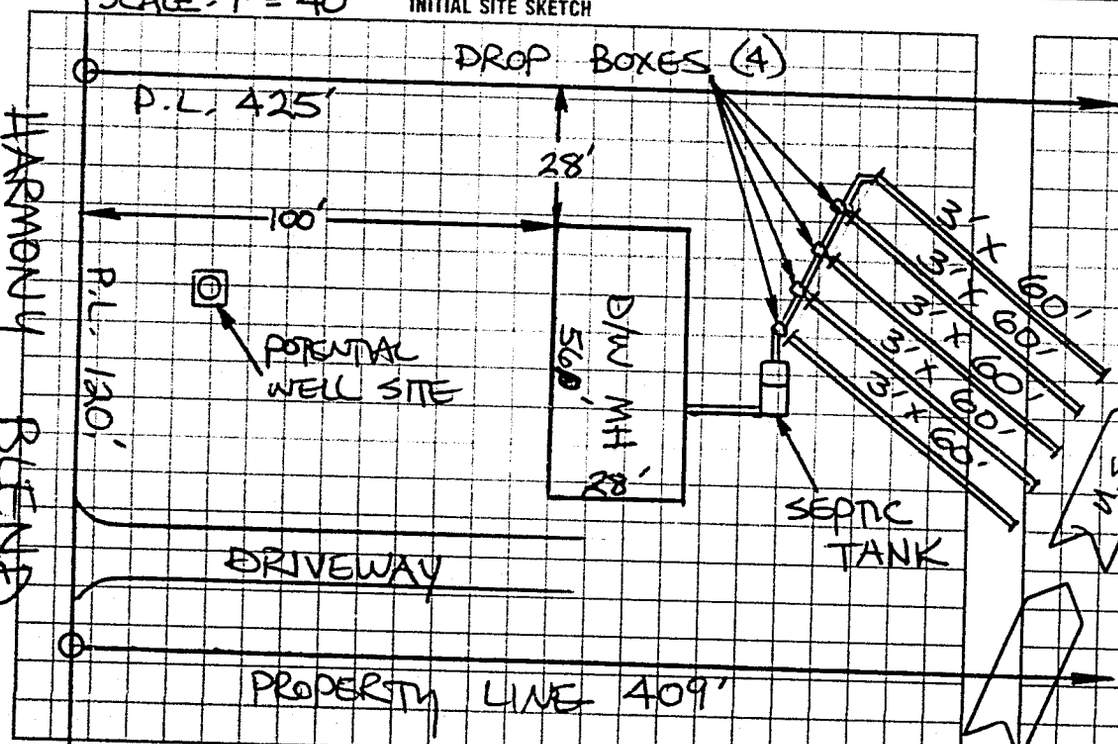

AS BUILT SKETCH

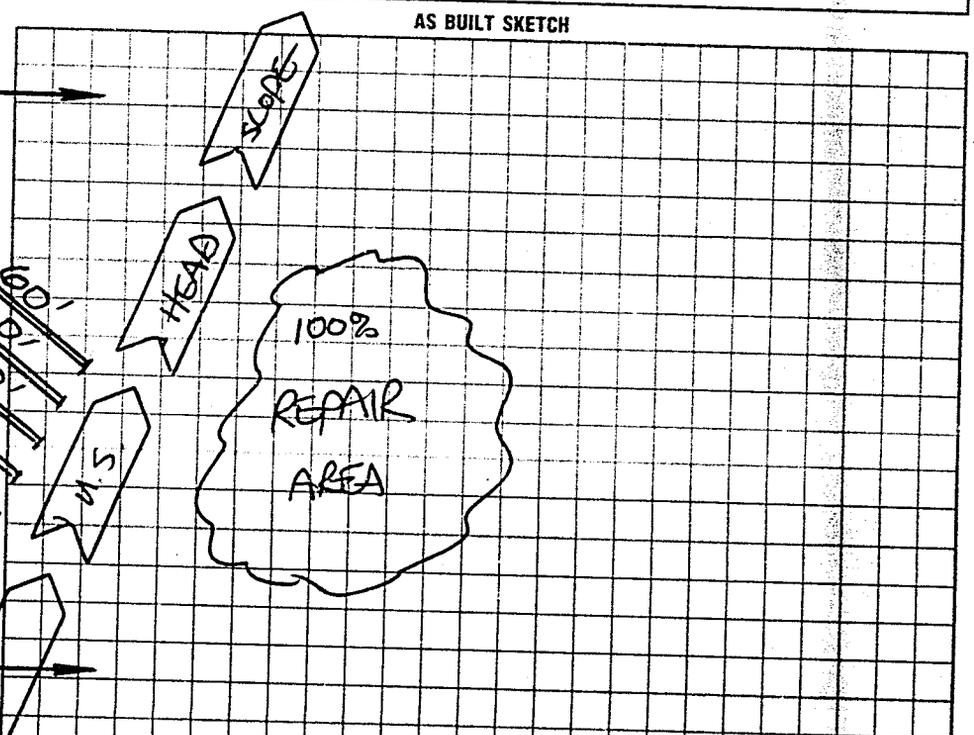

I understand that this permit can be suspended or revoked if any false information is supplied toward securing the permit/any unauthorized changes are made to the site/any unauthorized changes are made in the installation of the system. Improvement Permit with plat valid without expiration. Improvement Permit with site plan valid for sixty months. Authorization to Construct is valid for a period equal to that of Improvement Permit – not to exceed sixty months.

Signed: Claudette Ballard date 11-5-98

Improvement Permit by: STEVE HEDRICK date 11-4-98

Authorization to Construct by: STEVE HEDRICK date 11-4-98

Installed by: JAMES HUBER

Operation Permit by: STEVE HEDRICK date 11-19-98

Existing System Inspection by: date

HEALTH DEPT. COPY: WHITE INSPECTION COPY (FINAL): GREEN OWNER COPY (FINAL): YELLOW INSPECTION COPY (INITIAL): PINK OWNER COPY (INITIAL): ~~YELLOW~~