IREDELL COUNTY HEALTH DEPARTMENT

STATESVILLE 704-878-5305 MOORESVILLE 704-664-5281

IMPROVEMENT PERMIT / AUTHORIZATION TO CONSTRUCT / OPERATION PERMIT / EXISTING SYSTEM INSPECTION

PERMIT# 077989 PIN# 4778 07 5063 (PT) DATE 12-14-98

OWNER OR CONTRACTOR AMERICAN LAND PHONE: Business 878-9595 Home

ADDRESS 1281 GARNER BAGNAL BLVD STATESVILLE, NC 28677

LOCATION US 21 North, TR CHIEF THOMAS ROAD, TR HARMONY BLEND DRIVE, 7th LOT ON RIGHT

SUBDIVISION EASTEN ACRES BLOCK / SECTION LOT 7 LOT AREA 1.10 ACRES SITE CLASS PS DESIGN FLOW 360 L.T.A.R. 0.30 GPD/FT²

Septic Tank: 1000 Gallons: STB 1012 Date 12-29-98
Pump Tank: Gallons: PT Date
Pump Make: Model: Serial No:
Nitrification Field: No. Fields 1 Square Feet 1200 Linear Feet 400
No. Lines FOUR Trench Width: 36" Max. Trench Bottom Depth 30"

✓ New System Repair System Type: (1) CONVENTIONAL GRAVITY
System Description: CONV. PUMP
Repair System Description:
Maintenance Agreement Required: Yes No
Gravel Depth: 12" Soil: ✓ Crawl Space: Basement w/plumbing: Basement w/o plumbing:


House/Mod. Home: No. Bedrooms 3
✓ Mobile Home: No. Bathrooms 2
Business: No. Employers
Other:

Water Supply: ✓ Individual Public Community
WELL


Comments/Conditions: (1) KEEP SYSTEM MINIMUM 100' FEET FROM WELL (2) CONSTRUCT SUBSURFACE INTERCEPT DRAWAGE DITCH AT LOCATION SHOWN BEGINNING 36"+ DEEP

Comments/Conditions: SEPTIC TANK W/ RISERS INSTALLED W/ "PAYLOR" FILTER AT OUTLET.

INITIAL SITE SKETCH SCALE: 1" = 50'

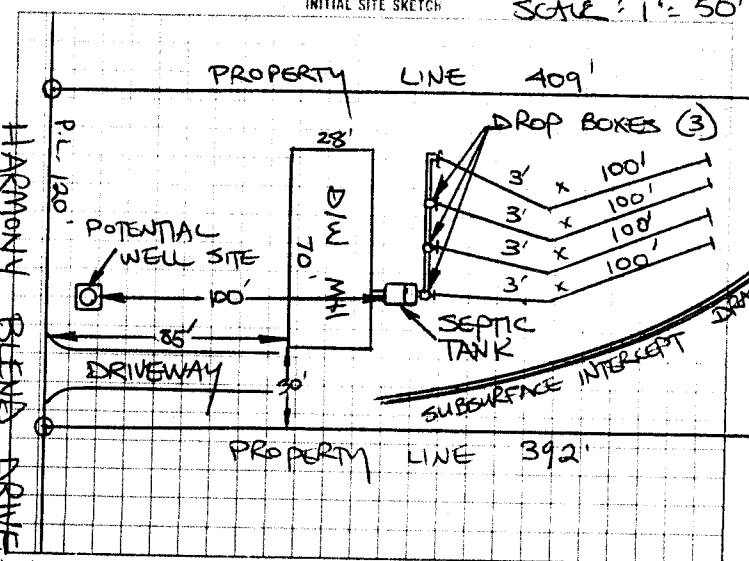

AS BUILT SKETCH

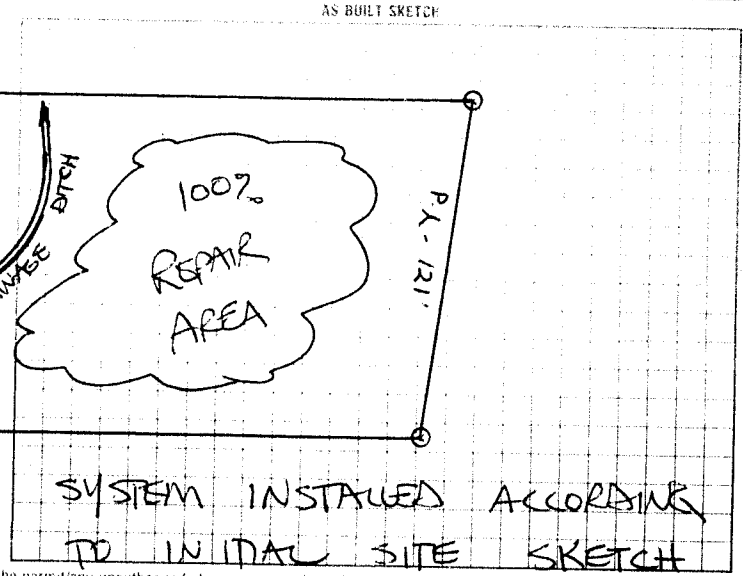

I understand that this permit can be suspended or revoked if any false information is supplied toward securing the permit/any unauthorized changes are made to the site/any unauthorized changes are made in the installation of the system. Improvement Permit with plat valid without expiration. Improvement Permit with site plan valid for sixty months. Authorization to Construct is valid for a period equal to that of Improvement Permit – not to exceed sixty months.

Signed: Claudette Bellard date 12-16-98

Improvement Permit by: STEVE HEDRICK date 12-14-98

Authorization to Construct by: STEVE HEDRICK date 12-14-98

Installed by: A-1 BACKHOE

Operation Permit by: STEVE HEDRICK date 3-11-99

Existing System Inspection by: date

HEALTH DEPT. COPY: WHITE INSPECTION COPY (FINAL) GREEN OWNER COPY (FINAL) YELLOW INSPECTION COPY (INITIAL) PINK OWNER COPY (INITIAL) GOLD