IREDELL COUNTY HEALTH DEPARTMENT

STATESVILLE 704-878-5305 MOORESVILLE 704-664-5281

IMPROVEMENT PERMIT / AUTHORIZATION TO CONSTRUCT / OPERATION PERMIT / EXISTING SYSTEM INSPECTION

PERMIT# 077990 PIN# 4778 07 5063 (PART) DATE 12-14-98

OWNER OR CONTRACTOR AMERICAN LAND PHONE: Business 878-9595 Home

ADDRESS 1281 GARNER BAGNAL BLVD, STATESVILLE NC 28677

LOCATION US 21 North, TR CHIEF THOMAS RD, TR HARMONY BLEND, LOT on LEFT

SUBDIVISION EASTEN ACRES BLOCK / SECTION LOT 30 LOT AREA 1.07 ACRES SITE CLASS PS DESIGN FLOW 360 L.T.A.R. 0.30 gpd/ft²

Septic Tank: 1000 Gallons: STB 794 Date 12-9-98
Pump Tank: Gallons: PT Date
Pump Make: Model Serial No.
Nitrification Field: No. Fields 1 Square Feet 1200 Linear Feet 400
No. Lines FOUR Trench Width 36" Max. Trench Bottom Depth 30" Gravel Depth 12" Soil Alt. Space Basement w/plumbing Basement w/o plumbing

✓ New System Repair System Type (I) II III IV V VI
System Description CONVENTIONAL GRAVITY
Repair System Description CONV. GRAVITY
Maintenance Agreement Required Yes ✓ No


✓ House/Mod. Home No. Bedrooms 3
✓ Mobile Home No. Bathrooms 2
Business No. Employees
Other

Water Supply: ✓ Individual ☐ Public ☐ Community
WELL

Comments/Conditions: KEEP SYSTEM MINIMUM 100 FEET FROM WELL

Comments/Conditions:

INITIAL SITE SKETCH SCALE: 1" = 50'

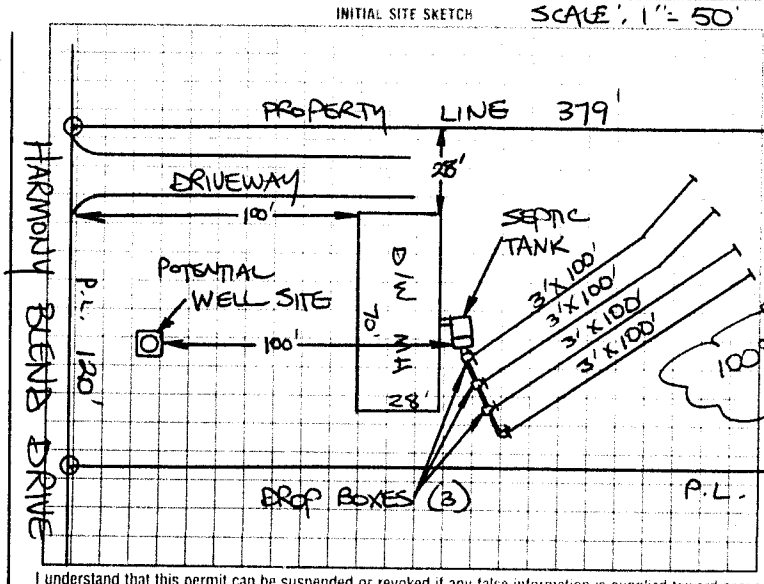

AS BUILT SKETCH

SYSTEM INSTALLED ACCORDING TO INITAL SITE SKETCH

I understand that this permit can be suspended or revoked if any false information is supplied toward securing the permit/any unauthorized changes are made to the site/any unauthorized changes are made in the installation of the system. Improvement Permit with plat valid without expiration. Improvement Permit with site plan valid for sixty months. Authorization to Construct is valid for a period equal to that of Improvement Permit – not to exceed sixty months.

Signed: Claudette Ballard date 12-16-98 Installed by: JAMES HUDLER

Improvement Permit by: STEVE HEDRICK date 12-14-98 Operation Permit by: STEVE HEDRICK date 1-28-99

Authorization to Construct by: STEVE HEDRICK date 12-14-98 Existing System Inspection by: date

HEALTH DEPT. COPY: WHITE INSPECTION COPY (FINAL): GREEN OWNER COPY (FINAL): YELLOW INSPECTION COPY (INITIAL): PINK OWNER COPY (INITIAL): GOLD