IREDELL COUNTY HEALTH DEPARTMENT

STATESVILLE 704-878-5305 MOORESVILLE 704-664-5281

IMPROVEMENT PERMIT / AUTHORIZATION TO CONSTRUCT / OPERATION PERMIT / EXISTING SYSTEM INSPECTION

PERMIT# 081801 PIN# 4778 17 7108 DATE 7-3-99

OWNER OR CONTRACTOR AMERICAN LAND PHONE: Business 878-9595 Home

ADDRESS 1281 GARNER BAGNAL BLVD, STATESVILLE NC 28677

LOCATION US21 N, TR CHIEF THOMAS TR HARMONY BLEND, LOT ON LEFT AT CURVE

SUBDIVISION EASTON ACRES BLOCK / SECTION II LOT 31 LOT AREA 1.04 ACRES SITE CLASS PS DESIGN FLOW 360 L.T.A.R. 0.30 GPD/FT²

Septic Tank: 1000 Gallons; STB 1012 Date 5-10-99
Pump Tank: Gallons; PT Date
Pump Make: Model Serial No
Nitrification Field: No Fields 1 Square Feet 1200 Linear Feet 400
No Lines FIVE Trench Width 36" Max Trench Bottom Depth 36" Gravel Depth 12"

☑ New System ☐ Repair System Type: I (II) III IV V VI
System Description: CONVENTIONAL GRAVITY
Repair System Description: CONV. GRAVITY
Maintenance Agreement Required: ☐ Yes ☑ No
☐ Slab ☑ Crawl Space ☐ Basement w/plumbing ☐ Basement wo/plumbing


☐ House/Mod. Home No. Bedrooms 3
☐ Mobile Home No. Bathrooms 2
☐ Business No. Employees
☐ Other

Water Supply: ☑ Individual ☐ Public ☐ Community WELL

Comments/Conditions: KEEP SYSTEM MINIMUM 100 FEET FROM WELL

Comments/Conditions:

INITIAL SITE SKETCH SCALE: 1" = 50'

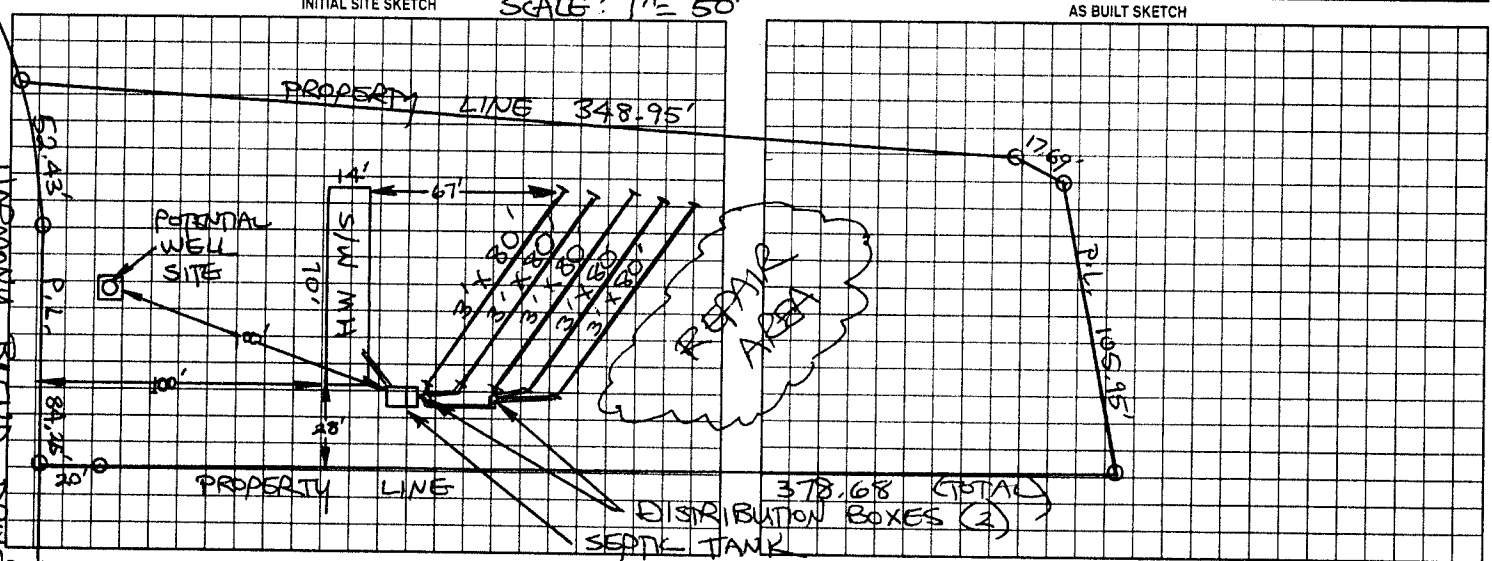

AS BUILT SKETCH

Permit can be suspended or revoked if any false information is supplied toward securing the permit/any unauthorized changes are made to the site/any unauthorized changes are made in the installation of the system. Improvement Permit with plat valid without expiration. Improvement Permit with site plan valid for sixty months. Authorization to Construct is valid for a period equal to that of Improvement Permit – not to exceed sixty months.

Signed: [signature] date 7-6-99 Installed by: A/ Backhoe

Improvement Permit by: STEVE HEDRICK date 7-3-99 Operation Permit by: [signature] date 7-14-99

Authorization to Construct by: STEVE HEDRICK date 7-3-99 Existing System Inspection by: date

HEALTH DEPT COPY WHITE OWNER COPY (FINAL) YELLOW OWNER COPY (INITIAL) PINK